


Jefferson

Section 21 Township 9 Range 20-E

Well No. #2 Hesse

Company Hatcher & Fisk

McLouth Pool

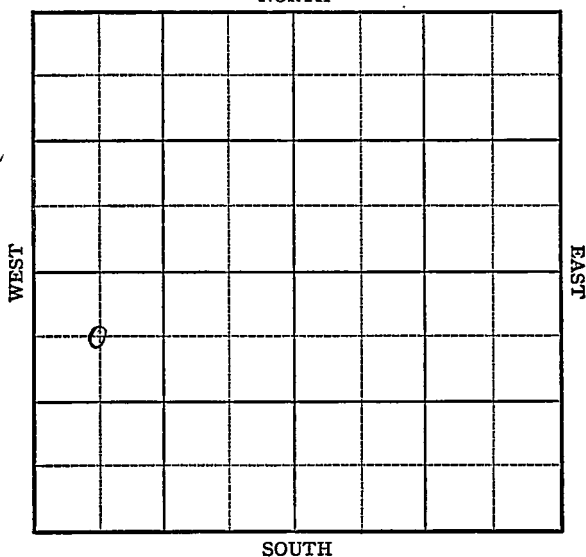

KANSAS

Jefferson

Sec. 21 Twp. 9 R. 20-E

Well No. #2 Hesse Farm

Hatcher & Fisk Company

(McLouth Pool)


660 Ft. from N. Line

 Ft. from S. Line

 Ft. from E. Line

660 - Ft. from W. Line

Elev. 1050

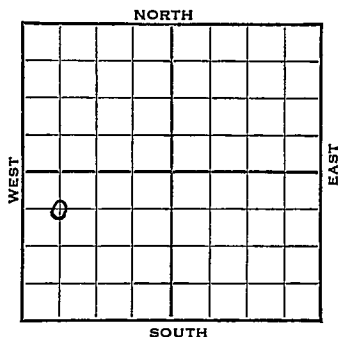

1942

REPORT

9/2 Machine.

9/9 Drlg 540

9/16 8" @ 880 Drlg 1000'

9/23 6" 1393
Gas 145-60² T.D. 1560 11 Million gas

9/30 " " " " "

10/7 Sand 1445
6" - 1393

Gas 11,700,000 Gas
T.D. 1460

COMPLETED

Jefferson KANSAS

Map No. MM Sec. 21 Twp. 9 R. 20EWell No. 2 HesseHatcher & Fisk Company**FIRST REPORT** Contractor

C NW SW

660 Ft. from N. Line Ft. from S. Line Ft. from E. Line660 Ft. from W. Line

SECTION PLAT

0			

MCLOUTH POOLLocation Rig up

Drilling and Remarks:

Machine

RECORD

Cased in., ft.Sand Gas Oil Total Depth

PRODUCTION

1st 24 hrs. Nat. 1st 24 hrs. after shot Gas Cu. Ft.Dry Hole Abandoned

Date

SEP 2 1942 19S. J. LEWIS Scout

Jefferson KANSAS

Map No. NM Sec. 21 Twp. 9 R. 20EWell No. 2 HesseHatcher & Fisk

Company

COMPLETED

Contractor

C NW SW

SECTION PLAT

660 Ft. from N. Line Ft. from S. Line Ft. from E. Line660 Ft. from W. Line

MCLOUTH POOL

Location Rig up

Drilling and Remarks:

Sanol 1445-6" @ 1293.11,700,000 Gas

RECORD

Cased in., ft.Sand Gas Oil Total Depth 1460

PRODUCTION

1st 24 hrs. Nat. 1st 24 hrs. after shot Gas Cu. Ft.Dry Hole Abandoned

Date

OCT 7 1942 19S. J. LEWIS

Scout