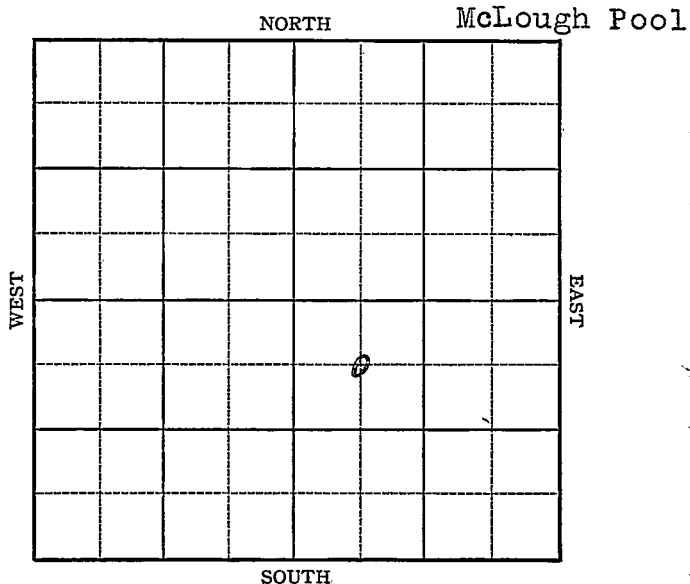


KANSAS

Jefferson

FORM 51 5M 1-42 PETROL

Section 21 Township 9 Range 20-EWell No. #1 MosbergerCompany O. J. Connell et al

Map No. MM Sec. 21 Twp. 9 R. 20EWell No. 1 MosbergerO. J. Connell et al. Company

FIRST REPORT

Contractor

C NW SE

SECTION PLAT

		e	

660 Ft. from N. Line Ft. from S. Line Ft. from E. Line660 Ft. from W. Line

MCLOUTH POOL

Location Rig up

Drilling and Remarks:

10" - 103'Dr1g. 110'

RECORD

Cased in., ft.Sand Gas Oil Total Depth

PRODUCTION

1st 24 hrs. Nat. 1st 24 hrs. after shot Gas Cu. Ft.Dry Hole Abandoned

Date

APR 8 1942 19S. J. LEWIS Scout

Jefferson

KANSAS

Map No. NM Sec. 21 Twp. 9 R. 20EWell No. 1 MosbergerO. J. Connell et al. CompanyABANDONED Contractor

SECTION PLAT

		o	
i			

C NW SE

660 Ft. from N. Line

_____ Ft. from S. Line

_____ Ft. from E. Line

660 Ft. from W. Line

MCLOUTH POOL

Location _____

Rig up _____

Drilling and Remarks:

Sanal 1445Miss 1460Noshow

RECORD

Cased _____ in., _____ ft.

Sand _____

Gas _____

Oil _____

Total Depth 1538

PRODUCTION

1st 24 hrs. Nat. _____

1st 24 hrs. after shot _____

Gas _____ Cu. Ft.

Dry Hole _____

Abandoned _____

Date

APR 29 1942 19S. J. LEWIS Scout