

KANSAS


FORM 51 5M 4-41 PETROL

Jefferson

Section .21 Township 9 Range 20-E

Well No. #2 R. Edmonds

Company Hatcher & Fisk

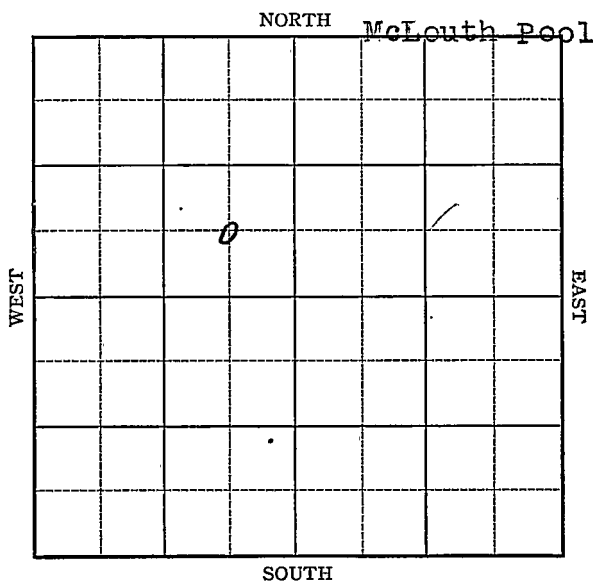

KANSAS

Jefferson

Sec. 21 Twp. 9 R. 20-E

Well No. #2 R. Edmonds Farm

Hatcher & Fisk Company


(McLouth)

 Ft. from N. Line

660 Ft. from S. Line

660 Ft. from E. Line

 Ft. from W. Line

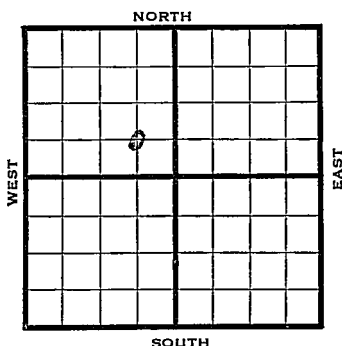

1942

REPORT

6/24

Machine.

7/1

Drlg. 400'

7/8

Sand 1423' 5" - 1423' WOC.

7/15

Sand 1423'

5" - 1423'

T.D. 1430'

2,250,000 cu. ft. gas.

COMPLETED

Jefferson

KANSAS

Map No. MM Sec. 21 Twp. 9 R. 20EWell No. 2 R. Edmonds

Hatcher & Fisk


Company

FIRST REPORT

Contractor

C SE NW

SECTION PLAT

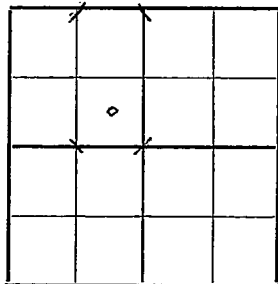

_____ Ft. from N. Line

660 Ft. from S. Line660 Ft. from E. Line

_____ Ft. from W. Line

MCLOUTH POOL

Location _____

Rig up _____

Drilling and Remarks:

Machine

RECORD

Cased _____ in., _____ ft.

Sand _____

Gas _____

Oil _____

Total Depth _____

PRODUCTION

1st 24 hrs. Nat. _____

1st 24 hrs. after shot _____

Gas _____ Cu. Ft.

Dry Hole _____

Abandoned _____

Date

JUN 24 1942 19S. J. LEWIS Scout

Please check location.

Paul.

This is the.

Misc. Small Maps	☒
Cards	☒
Tracing	☐
France Map	☒
Scarborough Map	☒
Moody Map	☐
Geological Dept.	☐
Moody Flat Book	☐

Jefferson KANSAS

Map No. NM Sec. 21 Twp. 9 R. 20EWell No. 2 R. EdmondsHatcher & Fisk

Company

COMPLETED

Contractor

C SE NW

 Ft. from N. Line660 Ft. from S. Line660 Ft. from E. Line Ft. from W. Line

SECTION PLAT

	o		

MCLOUTH POOL

Location Rig up

Drilling and Remarks:

Sand 14235" @ 14232,250,000 @ w ftGas

RECORD

Cased in., ft.Sand Gas Oil Total Depth * 1430


PRODUCTION

1st 24 hrs. Nat. 1st 24 hrs. after shot Gas Cu. Ft.Dry Hole Abandoned

Date

JUL 15 1942 19S. J. LEWIS Scout


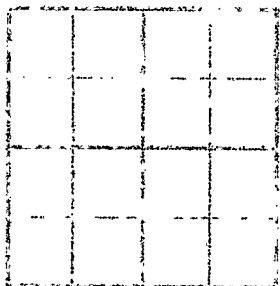








Misc. Small Maps

Cards

Tracing

France Map

Scarborough Map

Moody Map

Geological Dept.

Moody Flat Book