

KANSAS

FORM 51 5M 10-41 PETROL

Leavenworth


Section 22 Township 9 Range 20-E

Well No. #1 Miller

Company Chas. Miller

McLouth Pool

NORTH

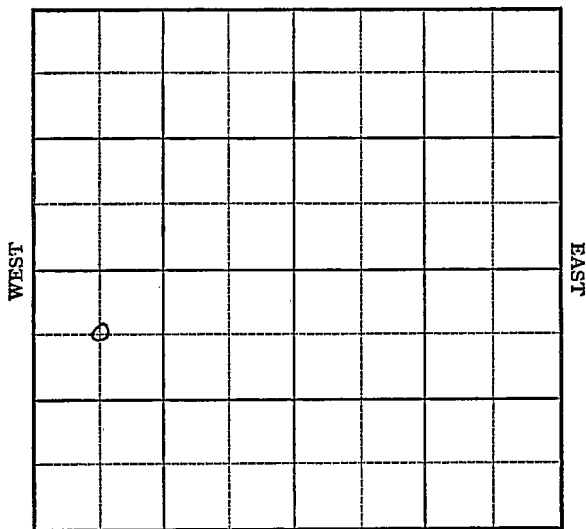

SOUTH

KANSAS


Leavenworth

Sec. 22 Twp. 9 R. 20-EWell No. #1 Miller FarmChas. Miller Company

(McLouth Pool)

660 Ft. from N. Line3 Ft. from S. Line Ft. from E. Line660 Ft. from W. Line

Elev. 1064

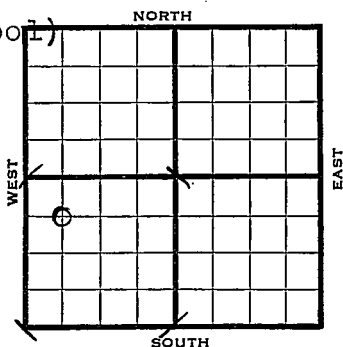

1942

REPORT

8/5 Spud 30'
8/12 10" @ 127 Drlg 470'
8/19 525 S.D.
8/27 "
9/2 Fishing 820'
9/9 " "
9/16 1050 Run cag.
9/23 T. D. 1430 6" 1429 WOC
9/30 McLouth 1429
6" 1429
Inc. gas 1430-44
Show oil 1444-47
TD 1447
Potential 8,000,000 Gas

COMPLETED

KANSAS
LeavenworthMap No. NM Sec. 22 Twp. 9 R. 20EWell No. 1 MillerChas. Miller


Company

FIRST REPORT

Contractor

C NW SW

SECTION PLAT

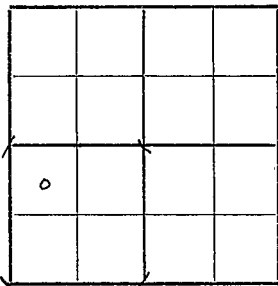660 Ft. from N. Line

Ft. from S. Line

Ft. from E. Line

660 Ft. from W. Line**MCLOUTH POOL**

Location

Rig up

Drilling and Remarks:

Spud 30'

RECORD

Cased _____ in., _____ ft.

Sand _____

Gas _____

Oil _____

Total Depth _____

PRODUCTION

1st 24 hrs. Nat. _____

1st 24 hrs. after shot _____

Gas _____ Cu. Ft.

Dry Hole _____

Abandoned _____

Date

AUG 5 1942 19

S. J. LEWIS Scout

Misc. Small Maps	☒
Cards	<i>Small</i>
Tracing	
France Map	☒
Scarborough Map	☒
Moody Map	
Geological Dept.	
Moody Plat Book	

KANSAS

Leavenworth

Map No. 11M Sec. 22 Twp. 9 R. 20EWell No. 1 MillerChas. Miller

Company

Contractor

C NW SW

SECTION FLAT

o			

660 Ft. from N. Line Ft. from S. Line Ft. from E. Line660 Ft. from W. Line

MCLOUTH POOL

Location Rig up

Drilling and Remarks:

Inc Gas 1430-44
Show Oil 1444-47

Potential
8,000,000 Gas

RECORD

Cased 6 in., 1429 ft.Sand Gas Oil Total Depth 1447

PRODUCTION

1st 24 hrs. Nat. 1st 24 hrs. after shot Gas Cu. Ft.Dry Hole GAS WellAbandoned Date **COMPLETED**SEP 30 1942 19S. J. LEWIS Scout

McLouth 1429

Misc. Small Maps	<i>RSV</i>	*
Cards		
Tracing		
France Map		
Scarborough Map		*
Moody Map		
Geological Dept.		
Moody Flat Book		