


Section 23 Township 9 Range 21-#

Well No. #1 Corlett

Company Chas. Miller

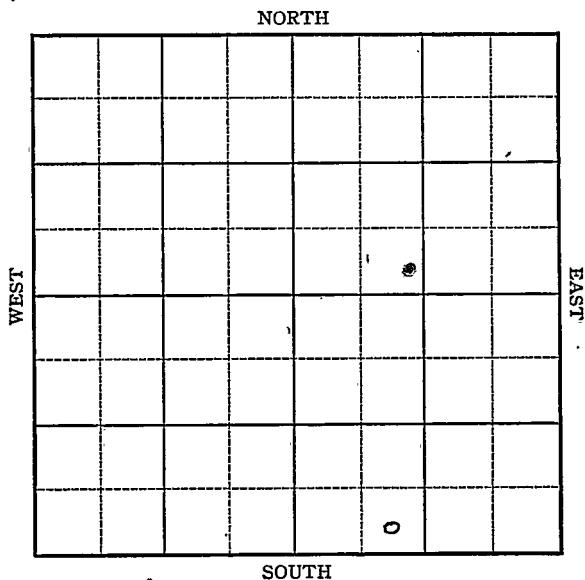

Sec. 23 Twp. 9 R. 21-E

Well No. #1 Corlett Farm


Chas. Miller Company

 Ft. from N. Line

330 Ft. from S. Line

 Ft. from E. Line

990 Ft. from W. Line

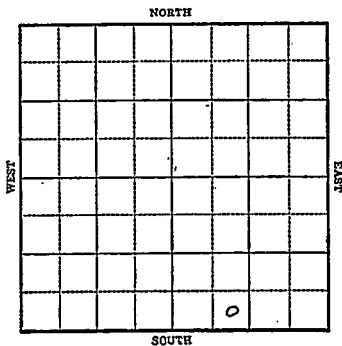

1944

R E P O R T

1-12

Moving in cable tools

1/19

" " " "

1/26

" "

2/2

Miss 1395

TD 1555

HFW

ABANDONED

KANSAS

Map No. 211 Sec. 23 Twp. 9 R. 21EWell No. 1 CorlettChas. Miller

Company

ABANDONED

Contractor

SE SW SE

SECTION PLAT

 Ft. from N. Line330 Ft. from S. Line Ft. from E. Line990 Ft. from W. LineMcLouth PoolLocation Rig up

Drilling and Remarks:

*Miss 1395-**AFW*

RECORD

Cased in., ft.Sand Gas Oil Total Depth 155.5

PRODUCTION

1st 24 hrs. Nat. 1st 24 hrs. after shot Gas Cu. Ft.Dry Hole Abandoned

Date

FEB 2 1944

19

S. J. LEWIS

Scout

KANSAS
 Map No. 757 Sec. 23 Twp. 9 R. 21E

Well No. 1 Corlett


Chas. Miller Company

FIRST REPORT

Contractor

SE SW SE

SECTION PLAT

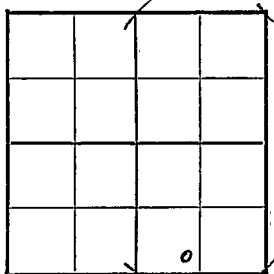

 Ft. from N. Line

330

 Ft. from S. Line

 Ft. from E. Line

990

 Ft. from W. Line

McLouth Pool

Location

Rig up

Drilling and Remarks:

Moving in cable
tools

RECORD

Cased in., ft.

Sand

Gas

Oil

Total Depth

PRODUCTION

1st 24 hrs. Nat.

1st 24 hrs. after shot

Gas Cu. Ft.

Dry Hole

Abandoned

Date

JAN 1 2 1944 19

S. J. LEWIS Scout