

KANSAS


FORM 51 5M PETROL

Leavenworth

Section 25 Township 9 Range 21-E


Well No. #1 Barnhardt

Company Chas. Miller

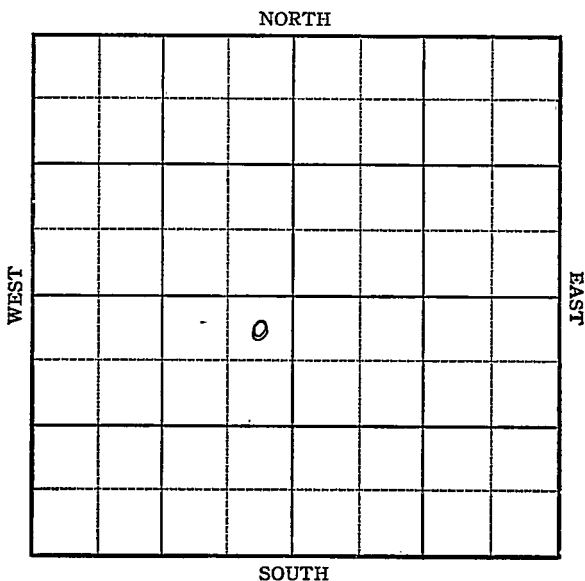

KANSAS

Leavenworth

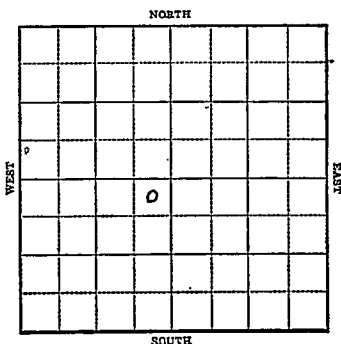Sec. 25 Twp. 9 R. 21-EWell No. #1 Barnhardt FarmChas. Miller Company330 Ft. from N. Line Ft. from S. Line330 Ft. from E. Line Ft. from W. Line

1943

948' REPORT

10/6 Location

10/13 "

10/20 Mach.

10/27 10" @ 22'
Drlg. 35'11/3 8" @ 668'
Drlg. 1050'

11/10 " "

11/17 Miss 1277
T.D. 1446

ABANDONED

Map No. KANSAS Sec. 25 Twp. 9 R. 21E

Well No. 1 Barnhardt

Chas. Miller Company

ABANDONED Contractor

NE SW


SECTION PLAT

330 Ft. from N. Line

_____ Ft. from S. Line

330 Ft. from E. Line

_____ Ft. from W. Line

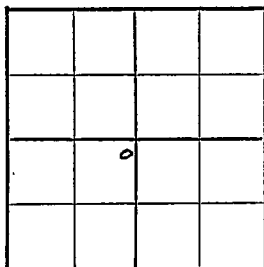

McLouth Pool

Location _____

Rig up _____

Drilling and Remarks:

Wier 1279

RECORD

Cased _____ in., _____ ft.

Sand _____

Gas _____

Oil _____

Total Depth 1446 ft.

PRODUCTION

1st 24 hrs. Nat. _____

1st 24 hrs. after shot _____

Gas _____ Cu. Ft.

Dry Hole _____

Abandoned _____

Date

NOV 17 1943

19

S. I. LEWIS

Scout

KANSAS

Map No. 111 Sec. 25 Twp. 9 R. 21EWell No. 1 Barnhardt

Chas. Miller

Company

FIRST REPORT

Contractor

NE SW

SECTION PLAT

330 Ft. from N. Line

Ft. from S. Line

330 Ft. from E. Line

Ft. from W. Line

	0		

McLouth Pool

Location X

Rig up

Drilling and Remarks:

RECORD

Cased 1 in. 1 ft.Sand 1

Gas

Oil

Total Depth

PRODUCTION

1st 24 hrs. Nat. 11st 24 hrs. after shot 1Gas 1 Cu. Ft.Dry Hole 1Abandoned 1

Date

OCT 6 1943 19

S. J. LEWIS Scout