

15 027 00028 0000

FORM 51 25M 8-50 WESTERN

Clay KANSAS

Section 27 Township 9 Range 4 E

Well No. # 1 Weise


Company ~~K. I. Turner~~ Mohoney-Fehr & Freeman

NORTH

WEST

EAST

SOUTH

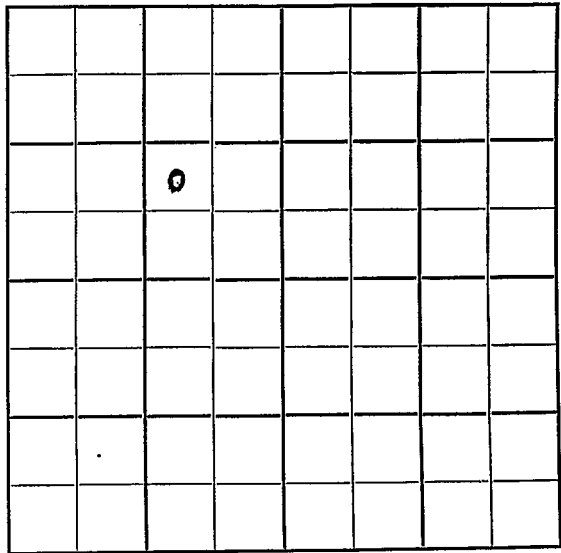

Clay

KANSAS




Sec. 27 Twp. 9 R. 4 E

Well No. # 1 Weise Farm
Moloney - Felt & Freeman
K. I. Turner Company

Slusser Contractor
Wildcat

..... Ft. from N. Line
990 Ft. from S. Line
990 Ft. from E. Line
..... Ft. from W. Line

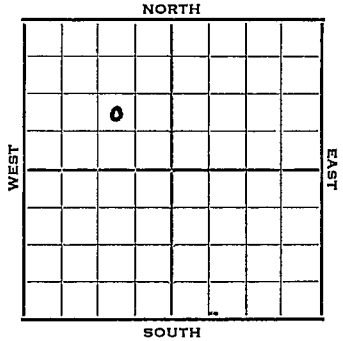

NW SE NW

1952 - REPORT

6/11 MI
9/17 Spud 5-7-52
D&A TD 1920' 8" @ 165'
Miss. 1883' TD 1920'
DST 1882-90 open 1 hr. rec. 3' mud
D&A

ABANDONED

County Clay State Kansas

Sec. 27 (Blk. Twp.) 9 (Sur. Rge.) 4E Map No.

Operator K. I. Turner

Well No. 1 Farm Weise

Elev. _____ Location NW SE NW

	0				

FIRST REPORT

990 Ft. From S Line NW

990 Ft. From E Line Quarter

Ist. Report JUN 11 1952

Completion _____

Remarks _____

Slusser - Contr.

Spudding Date _____

Drlg. Data Wildcat

MI

J. G. MCGHEE

Map No. _____ Sec. 27 Twp. 9 R. 4E

Well No. 1 Weise

Mohoney-Fehr & Freeman Company

CORRECTION Contractor

NW SE NW

SECTION PLAT

_____ Ft. from N. Line

990 Ft. from S. Line

990 Ft. from E. Line

_____ Ft. from W. Line

	Q		

RECORD

Location _____

Rig up _____

Drilling and Remarks:

Reported

K. I. Turner

1 Weise

Cased _____ in., _____ ft.

Sand _____

Gas _____

Oil _____

Total Depth _____

PRODUCTION

1st 24 hrs. Nat. _____

1st 24 hrs. after shot _____

Gas _____ C

Dry Hole _____

Abandoned _____

Date

JUN 18 1952 19 _____

J. G. MCGEE