

KANSAS

Jefferson


FORM 51 5M 4-41 PETROL

Section 28 Township 9 Range 20-E

Well No. 1 Miller

Company McLaughlin

NORTH McLouth Pool

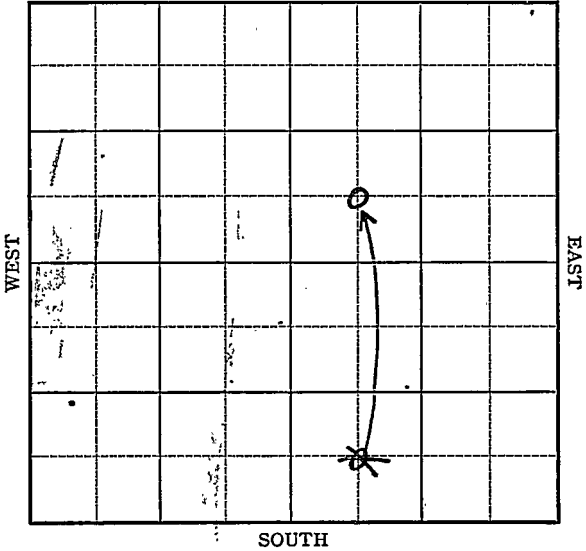

KANSAS

Jefferson

Sec. 28 Twp. 9 R. 20-E

Well No. #1 Miller Farm

McLaughlin Company


(McLouth)

         Ft. from N. Line

660 Ft. from S. Line

         Ft. from E. Line

660 Ft. from W. Line

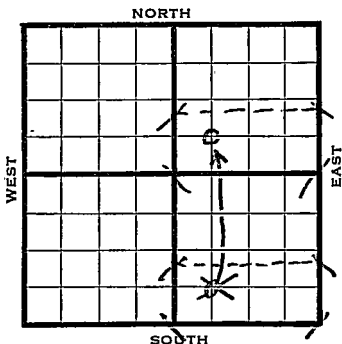

| 1942 | REPORT                                              |
|------|-----------------------------------------------------|
| 6/24 | Machine.                                            |
| 7/1  | 10" - 43' Drlg. 335'                                |
| 7/8  | Drlg. 950'                                          |
| 7/15 | 8" - 880' Drlg. 1348'                               |
| 7/22 | 6" @ 1394'                                          |
|      | Sand 1394'                                          |
|      | T.D. 1415'                                          |
|      | 4 1/2 M Gas.                                        |
|      | <p style="text-align: center;"><b>COMPLETED</b></p> |

Map No. NM Sec. 28 Twp. 9 R. 20EWell No. 1 MillerMcLaughlin


Company

## FIRST REPORT

Contractor

C SW SE

## SECTION PLAT

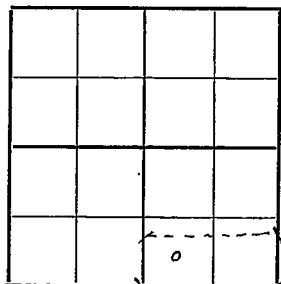         Ft. from N. Line660 Ft. from S. Line         Ft. from E. Line660 Ft. from W. Line

MCLOUTH POOL

## RECORD

Location                         Cased          in.,          ft.Rig up                         Sand                         

Drilling and Remarks:

Gas                         

Machine

Oil                         Total Depth                         

## PRODUCTION

1st 24 hrs. Nat.                         1st 24 hrs. after shot                         Gas                          Cu. Ft.Dry Hole                         Abandoned                         

Date

JUN 24 1942 19

S. J. LEWIS

Scout

Jefferson **KANSAS**Map No. MM Sec. 28 Twp. 9 R. 20EWell No. 1 MillerMcLaughlin


Company

**CORRECTION**

Contractor

C SW NE

## SECTION PLAT

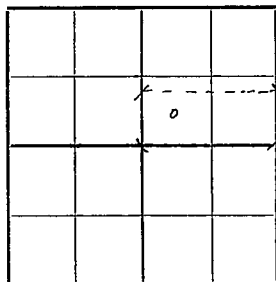

Ft. from N. Line

660 Ft. from S. Line

Ft. from E. Line

660 Ft. from W. LineMCLOUTH POOL

Location \_\_\_\_\_

Rig up \_\_\_\_\_

Drilling and Remarks:

Reported

C SW SE

## RECORD

Cased \_\_\_\_\_ in., \_\_\_\_\_ ft.

Sand \_\_\_\_\_

Gas \_\_\_\_\_

Oil \_\_\_\_\_

Total Depth \_\_\_\_\_

## PRODUCTION

1st 24 hrs. Nat. \_\_\_\_\_

1st 24 hrs. after shot \_\_\_\_\_

Gas \_\_\_\_\_ Cu. Ft.

Dry Hole \_\_\_\_\_

Abandoned \_\_\_\_\_

Date

JUL 1 1942 19S. J. LEWIS

Scout

Map No. NM Sec. 28 Twp. 9 R. 20EWell No. 1 MillerMcLaughlin

Company

COMPLETED

Contractor

C SW NE

## SECTION PLAT

|  |  |   |  |
|--|--|---|--|
|  |  |   |  |
|  |  | o |  |
|  |  |   |  |
|  |  |   |  |

\_\_\_\_\_ Ft. from N. Line

660

\_\_\_\_\_ Ft. from S. Line

\_\_\_\_\_ Ft. from E. Line

660

\_\_\_\_\_ Ft. from W. Line

McLOUTH POOL

## RECORD

Location \_\_\_\_\_

Cased \_\_\_\_\_ in., \_\_\_\_\_ ft.

Rig up \_\_\_\_\_

Sand \_\_\_\_\_

Drilling and Remarks:

Gas \_\_\_\_\_

Oil \_\_\_\_\_

Total Depth 1415

## PRODUCTION

1st 24 hrs. Nat. \_\_\_\_\_

1st 24 hrs. after shot \_\_\_\_\_

Gas \_\_\_\_\_ Cu. Ft.

Dry Hole \_\_\_\_\_

Abandoned \_\_\_\_\_

Date

JUL 22 1942

19

S. J. LEWIS Scout