

KANSAS


FORM 51 5M 10-41 PETROL

Jefferson

Section 28 Township 9 Range 20-E

Well No. #1 Old Line Insurance

Company Workman

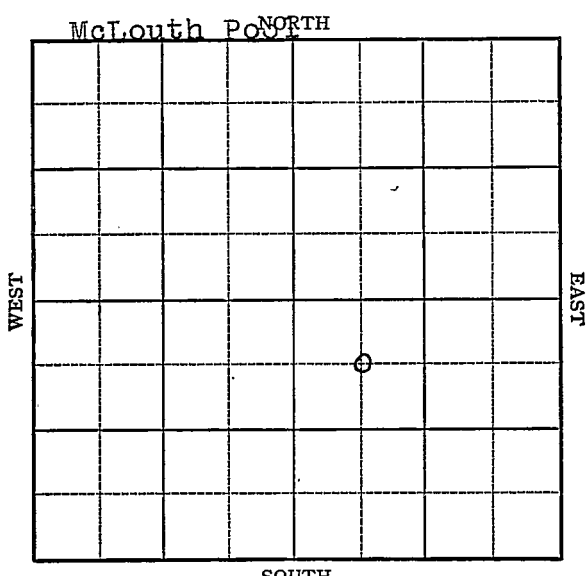

KANSAS

Jefferson

Sec. 28 Twp. 9 R. 20-E

Well No. #1 Old Line Insurance Farm

Workman _____ Company

(McLouth Pool)


660 Ft. from N. Line

_____ Ft. from S. Line

_____ Ft. from E. Line

660 Ft. from W. Line

Elev. 1068

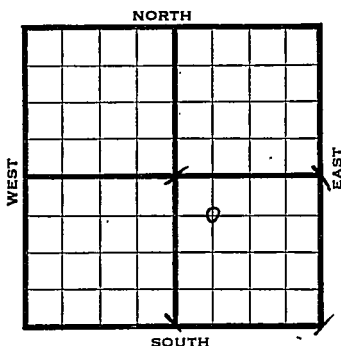

1942	REPORT
8/19	10" - 80' Drlg. 200'
8/27	Drlg 365
9/2	8" - 824 Drlg. 1050'
9/9	S Gas 1430-35 SD
9/16	Bart 1430 8/10 M gas 1437 5" @ 1421 SO 1452-56 Miss 1456 TD 1470 PB 1440
9/23	Sand 1430 5" 1421 Miss. 1456 TD 1470 PB 1440 8/10 M Gas
	COMPLETED

Jefferson

KANSAS

Map No. MM Sec. 28 Twp. 9 R. 20EWell No. 1 Old Line Insurance

Workman _____ Company _____

FIRST REPORT

Contractor _____

C NW SE


660 Ft. from N. Line

_____ Ft. from S. Line

_____ Ft. from E. Line

660 Ft. from W. Line

SECTION PLAT

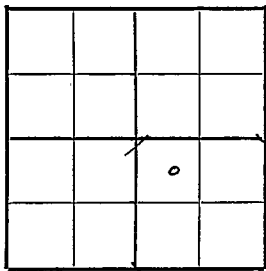

MCLOUTH POOL

Location _____

Rig up _____

Drilling and Remarks:

10"-80'

Drlg. 200'

RECORD

Cased _____ in., _____ ft.

Sand _____

Gas _____

Oil _____

Total Depth _____

PRODUCTION

1st 24 hrs. Nat. _____

1st 24 hrs. after shot _____

Gas _____ Cu. Ft.

Dry Hole _____

Abandoned _____

Date

AUG 19 1942 19

S. J. LEWIS

Scout

KANSAS

Map No. MM Sec. 28 Twp. 9 R. 20EWell No. 1 Old Line Insurance

Workman

Company

COMPLETED

Contractor

C NW SE

660 Ft. from N. Line

Ft. from S. Line

Ft. from E. Line

660 Ft. from W. Line

SECTION PLAT

MCLOUTH POOL

RECORD

Location

Cased _____ in., _____ ft.

Rig up

Sand _____

Drilling and Remarks:

Gas _____

Oil _____

Total Depth 1470

PRODUCTION

1st 24 hrs. Nat. _____

1st 24 hrs. after shot _____

Gas _____ Cu. Ft.

Dry Hole _____

Abandoned _____

Date

SEP 23 1942

19

S. J. LEWIS Scout

*Donal 1430**5" @ 1421**Wire 1456**PB 1440**Flow Gas*