

KANSAS Jefferson

Sec. 28 Twp. 9 R. 20-E

Well No. #2 Harwood Farm

Hatcher & Fisk Company


(McLouth Pool)

 Ft. from N. Line

660 Ft. from S. Line

660 Ft. from E. Line

 Ft. from W. Line

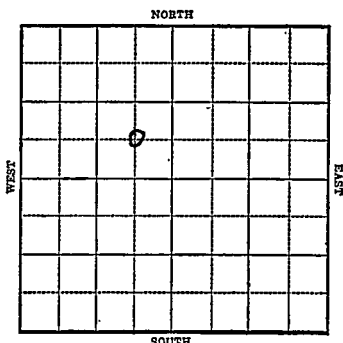

C SE NW

1942

R E P O R T

10/14

Location

10/21

10" @ 26' Drilg 345'

10/28

740 Dr/g.

11/4

Sand 1381'

6" @ 1381'

3,750,000 cu ft. Gas


TD 1396'

COMPLETED

Map No. MM Sec. 28 Twp. 9 R. 20EWell No. 2 HarwoodHatcher & Fisk CompanyFIRST REPORT Contractor

C SE NW

SECTION PLAT

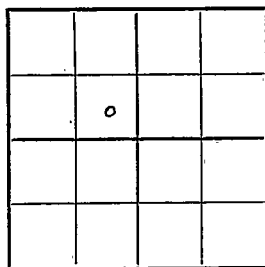 Ft. from N. Line660 Ft. from S. Line660 Ft. from E. Line Ft. from W. LineMCLOUTH POOLLocation XXXRig up

Drilling and Remarks:

RECORD

Cased in., ft.Sand Gas Oil Total Depth 231

PRODUCTION

1st 24 hrs. Nat. 1st 24 hrs. after shot Gas Cu. Ft.Dry Hole Abandoned

Date

OCT 14 1942

19

S. J. LEWIS Scout

Jefferson

KANSAS

Map No. 111 Sec. 28 Twp. 9 R. 20EWell No. 2 Harwood

Hatcher & Fisk


Company

COMPLETED

Contractor

C SE NW

SECTION PLAT

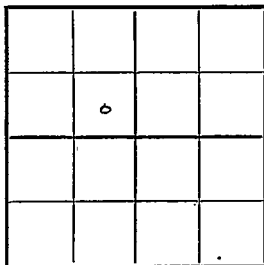

_____ Ft. from N. Line

660

_____ Ft. from S. Line

660

_____ Ft. from E. Line

_____ Ft. from W. Line

MCLOUTH POOL

Location _____

Rig up _____

Drilling and Remarks:

*Sand. 1381**6" @ 1381**3,750,000 cu ft**Gas*

RECORD

Cased _____ in., _____ ft.

Sand _____

Gas _____

Oil _____

Total Depth 1396

PRODUCTION

1st 24 hrs. Nat. _____

1st 24 hrs. after shot _____

Gas _____ Cu. Ft.

Dry Hole _____

Abandoned _____

Date

NOV 4 1942 19

S. J. LEWIS Scout