

KANSAS

FORM 51 5M 1-42 PETROL

Jefferson


Section 28 Township 9 Range 20E

Well No. #3 Harwood

Company Hatcher & Fisk

(McLouth Pool)

NORTH

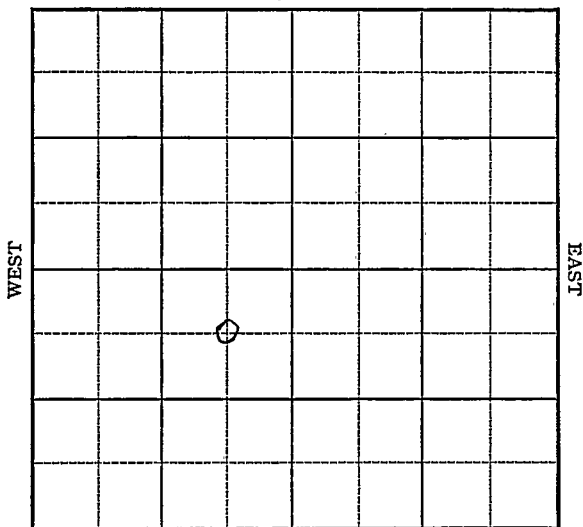

SOUTH

Sec. 28 Twp. 9 R. 20 ^E

Well No. #3 Harwood Farm

Hatcher & Fisk Company


McLouth Pool

660 Ft. from N. Line

_____ Ft. from S. Line

660 Ft. from E. Line

_____ Ft. from W. Line

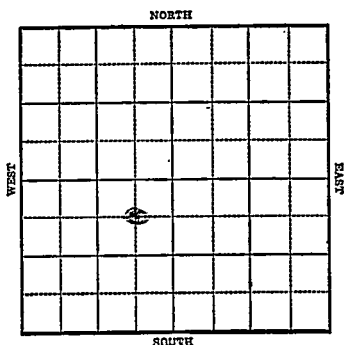

1942

R E P O R T

11/4 Location
 11/11 10" @ 72'
 Drlg. 135'

11/18 Drlg. 640

11/24 Bart. 1419
 6" @ 1420
 T.D. 1428'
 1 Million Gas

COMPLETED

KANSAS

Jefferson

Map No. 11/11 Sec. 28 Twp. 9 R. 20EWell No. 3 HarwoodHatcher & Fisk CompanyFIRST REPORT Contractor

C NE SW

660 Ft. from N. Line Ft. from S. Line660 Ft. from E. Line Ft. from W. Line

SECTION PLAT

	o		

MCLOUTH POOL

Location XXXRig up

Drilling and Remarks:

RECORD

Cased in., ft.Sand Gas Oil Total Depth

PRODUCTION

1st 24 hrs. Nat. 1st 24 hrs. after shot Gas Cu. Ft.Dry Hole Abandoned

Date

NOV 4 1942₁₉S. J. LEWIS Scout

KANSASMap No. MM Sec. 28 Twp. 9 R. 20EWell No. 3 HarwoodHatcher & Fisk CompanyCOMPLETED Contractor

C NE SW

660 Ft. from N. Line

_____ Ft. from S. Line

660 Ft. from E. Line

_____ Ft. from W. Line

SECTION PLAT

	o		

MCLOUTH POOL

Location _____

Rig up _____

Drilling and Remarks:

*Bar # 1419**6" @ 1420**1 M Gas*

RECORD

Cased _____ in., _____ ft.

Sand _____

Gas _____

Oil _____

Total Depth 1425

PRODUCTION

1st 24 hrs. Nat. _____

1st 24 hrs. after shot _____

Gas _____ Cu. Ft.

Dry Hole _____

Abandoned _____

Date

NOV 24 1942 19

S. J. LEWIS Scout