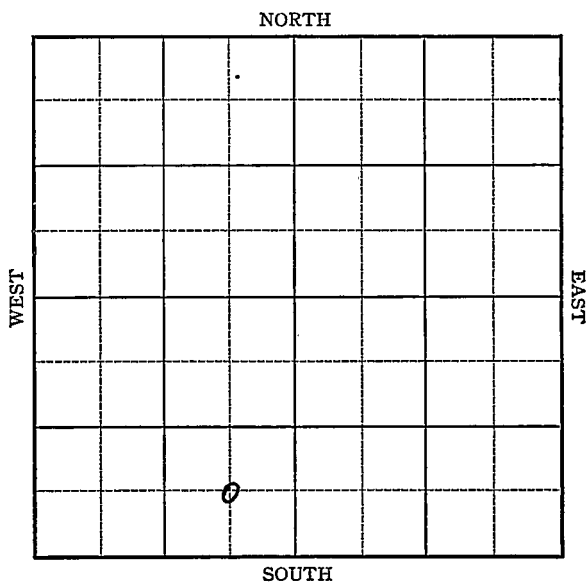
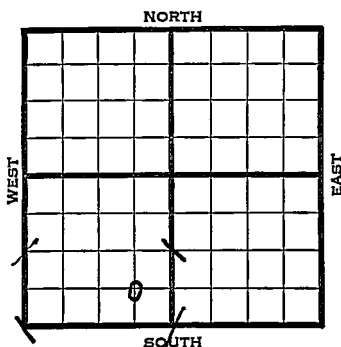


Jefferson KANSAS

Section 28 Township 9 Range 20EWell No. 1 SchroederCompany Willard-Archie

Sec. 28 Twp. 9 R. 20-EWell No. #1 Schroeder FarmWillard-Archie Company

(Misc.)

 Ft. from N. Line660 Ft. from S. Line660 Ft. from E. Line Ft. from W. Line

1941	REPORT
6/11	Machine.
6/19	SD 300'
6/26	10" - 40' 8" - 873'
	Drlg. 110'
7/3	7" - 1245' T.D. 1385' U.R. 7".
7/10	Miss. 1468-72' T.D. 140' fluid.
	U.R. 7". 21.3 Gravity
7/17	7" - 1442' P.B. to 1468'
	Shot 40 qts. 1442-68' 1100' oil
	12 hours. 0. 0.
7/24	" " " "
7/30	Bart 1442'
	Miss 1468'
	TD 1472'
	7" @ 1442'
	PB 1468'
	40 qts. 1442-68
	Pump 20 oil Potential
	1/3 M. Gas.
	28. Gravity.
	COMPLETED

Map No. MM Sec. 28 Twp. 9 R. 20E

Well No. 1 Schroeder

Willard-Archie Company

Contractor

FIRST REPORT

C SE SW


 Ft. from N. Line

660 Ft. from S. Line

660 Ft. from E. Line

 Ft. from W. Line

SECTION PLAT

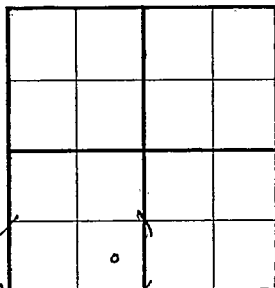

MISCELLANEOUS

Location

Rig up

Drilling and Remarks:

Machine

RECORD

Cased in., ft.

Sand

Gas

Oil

Total Depth

PRODUCTION

1st 24 hrs.-Nat.

1st 24 hrs. after shot

Gas Cu. Ft.

Dry Hole

Abandoned

Date

JUN 11 1941 19 S. J. LEWIS Scout

Jefferson **KANSAS**Map No. NM Sec. 28 Twp. 9 R. 20EWell No. 1 SchroederWillard-Archie CompanyContractor**COMPLETED**

C SE SW

 Ft. from N. Line660 Ft. from S. Line660 Ft. from E. Line Ft. from W. Line

MISCELLANEOUS

SECTION PLAT

	0		

Location Rig up

Drilling and Remarks:

Bar 1442.
Mis 1465.
7" @ 1442.
PB 1465.
40 gals. 1442-65.
Pump 20 oil P.S.
1/3 M Gas.
28° Gr.

RECORDCased in., ft.Sand Gas Oil Total Depth 1472**PRODUCTION**1st 24 hrs. Nat. 1st 24 hrs. after shot Gas Cu. Ft.Dry Hole Abandoned

Date

JUL 30 1941

19

S. J. LEWIS

Scout