


KANSAS
Jefferson

FORM 51 5M, 10-41 PETROL

Section 29 Township 9 Range 20-E

Well No. #1 R. E. Costigan

Company Ray Anderson et al.

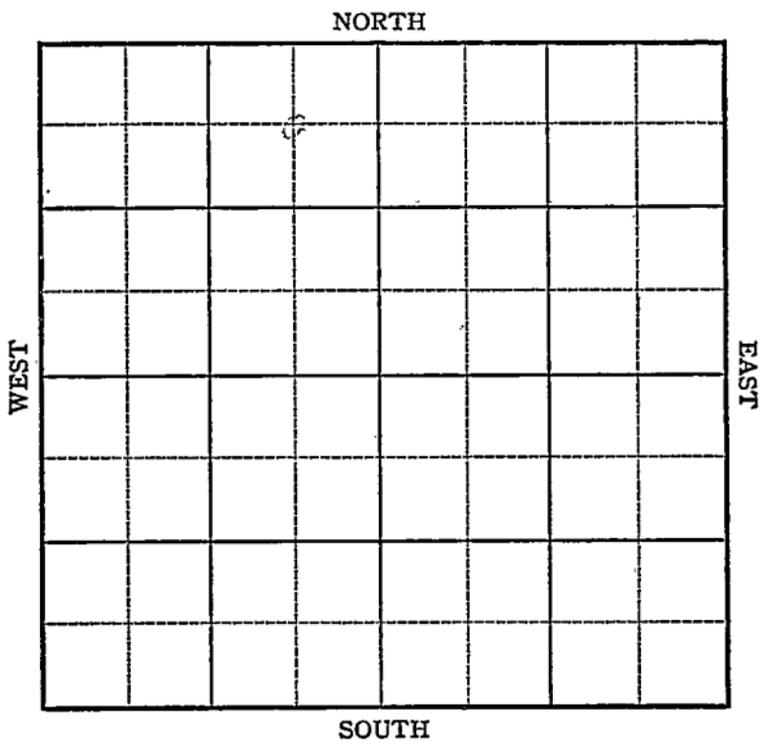

Sec. 29 Twp. 9 R. 20-E

Well No. #1 R. E. Costigan Farm

Ray Anderson et al Company


(Misc.)

660 Ft. from N. Line

_____ Ft. from S. Line

660 Ft. from E. Line

_____ Ft. from W. Line

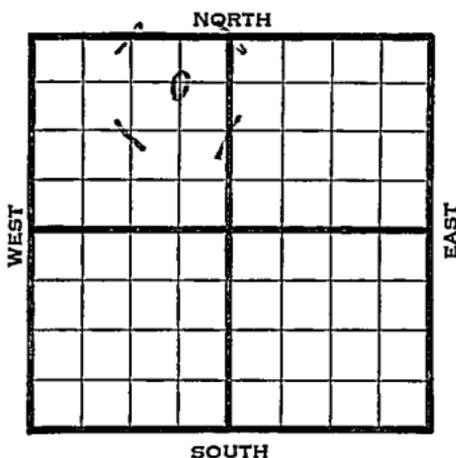

1941	REPORT
11/12	Location
11/20	"
12/4	Drilg. 495'
12/11	10" @ 71, 8" @ 850
	Sand 1416 6" @ 1416 SD
12/18	TD 1435, 14,300,000 cu. ft gas
12/23	Sand 1416'
	6" - 1416'
	T.D. 1435'
	14,300,000 cu. ft. gas.
	COMPLETED

Map No. MM Sec. 29 Twp. 9 R. 20EWell No. 1 R. E. CostiganRay Anderson et al. Company~~FIRST REPORT~~ Contractor

C NE NW

660 Ft. from N. Line Ft. from S. Line660 Ft. from E. Line Ft. from W. Line

SECTION PLAT

MISCELLANEOUS

Location XXRig up

Drilling and Remarks:

RECORD

Cased in., ft.Sand Gas Oil Total Depth

PRODUCTION

1st 24 hrs. Nat. 1st 24 hrs. after shot Gas Cu. Ft.Dry Hole Abandoned

Date

NOV 12 1941 19S. J. LEWIS Scout

Map No. MM Sec. 29 Twp. 9 R. 20E

Well No. 1 R. E. Costigan

Ray Anderson etal. Company

COMPLETED Contractor

C NE NW

SECTION PLAT

660 Ft. from N. Line

_____ Ft. from S. Line

660 Ft. from E. Line

_____ Ft. from W. Line

	o		

MISCELLANEOUS

RECORD

Location _____

Cased _____ in., _____ ft.

Rig up _____

Sand _____

Drilling and Remarks:

Gas _____

Oil _____

Total Depth 1435

=====

PRODUCTION

1st 24 hrs. Nat. _____

1st 24 hrs. after shot _____

Gas _____ Cu. Ft.

Dry Hole _____

Abandoned _____

Sand 114/6
6" @ 14/6
14,300,000 cu ft gas

Date

DEC 23 1941 19

S. J. LEWIS Scout