

KANSAS

Jefferson

FORM 51 5M 4-41 PETROL

Section 29 Township 9 Range 20-E

Well No. 1 Means


Company Anderson et al

Miscellaneous

NORTH

WEST

EAST

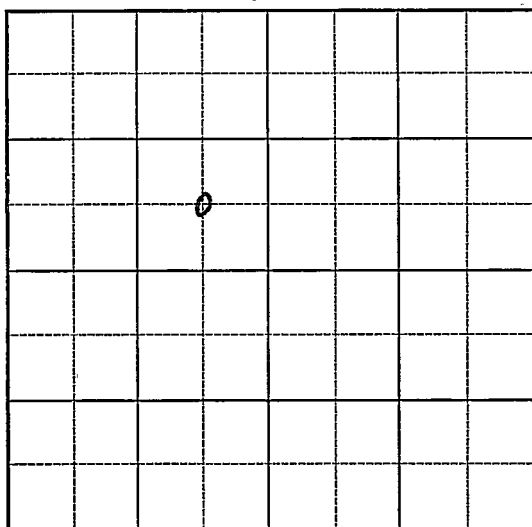

SOUTH

Map No. NM Sec. 29 Twp. 9 R. 20EWell No. 1 MeansAnderson et al

Company

FIRST REPORT

Contractor

C SE NW


Ft. from N. Line

660 Ft. from S. Line660 Ft. from E. Line

Ft. from W. Line

MISCELLANEOUS

SECTION PLAT

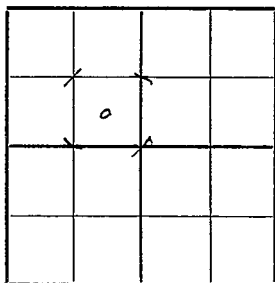Location X

Rig up

Drilling and Remarks:

RECORD

Cased _____ in., _____ ft.

Sand _____

Gas _____

Oil _____

Total Depth _____

PRODUCTION

1st 24 hrs. Nat. _____

1st 24 hrs. after shot _____

Gas _____ Cu. Ft.

Dry Hole _____

Abandoned _____

Date

AUG 27 1941 19S. J. LEWIS

Scout

Map No. 11 NW Sec. 29 Twp. 9 R. 20EWell No. 1 MeansAnderson et al CompanyCOMPLETED Contractor

SECTION PLAT

C SE NW

 Ft. from N. Line660 Ft. from S. Line660 Ft. from E. Line Ft. from W. Line

	o		

MISCELLANEOUS

RECORD

Location Rig up

Drilling and Remarks:

Bar 8/14346" @ 143418,600,000 @ w/ygas.Cased in., ft.Sand Gas Oil Total Depth 1454

PRODUCTION

1st 24 hrs. Nat. 1st 24 hrs. after shot Gas Cu. Ft.Dry Hole Abandoned

Date

SEP 24 1941 19S. J. LEWIS Scout