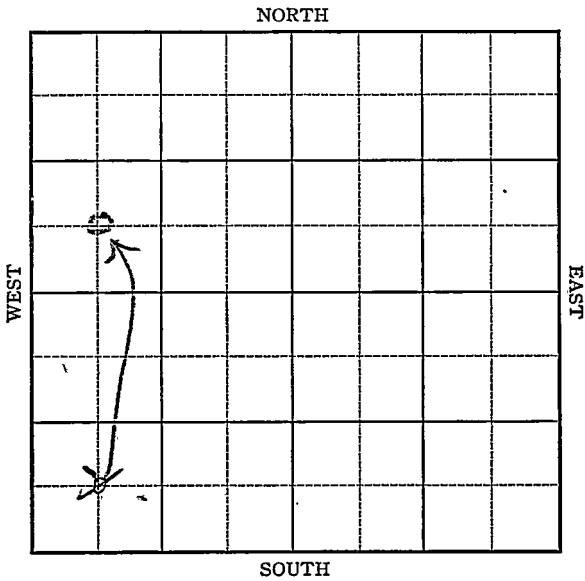



Section 29 Township 9 Range 20-EWell No. #1 WisdonCompany Anderson et al
(Misc.)

KANSAS

Jefferson

Sec. 29 Twp. 9 R. 20-EWell No. #1 Wisdom FarmAnderson et al Company
(Miscellaneous) Ft. from N. Line680
~~660~~ Ft. from S. Line Ft. from E. Line660 Ft. from W. Line

Elev. 1054

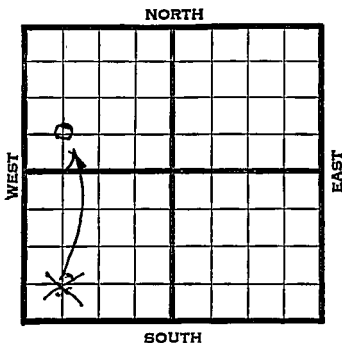

1941

REPORT

7/23

10" 37' Machine 670

7/31

Bart 1438'

6" @ 1440'

TD 1441 S Gas.

8/7

TD 1444½ 6 M Gas

8/13

Bartlesville 1438'

6-5/8" @ 1440

Rock Press. 505#

T.D. 1453'

15½ M. Gas.

COMPLETED

Map No. MM Sec. 29 Twp. 9 R. 20EWell No. 1 WisdonAnderson etal

Company

FIRST REPORT

Contractor

C SW SW

 Ft. from N. Line660 Ft. from S. Line Ft. from E. Line660 Ft. from W. Line

MISCELLANEOUS

SECTION PLAT

o			

Location Rig up

Drilling and Remarks:

10" - 37'Machine 670

RECORD

Cased in., ft.Sand Gas Oil Total Depth

PRODUCTION

1st 24 hrs. Nat. 1st 24 hrs. after shot Gas Cu. Ft.Dry Hole Abandoned

Date

JUL 23 1941 19 S. J. LEWIS Scout

KANSASMap No. NM Sec. 29 Twp. 9 R. 20EWell No. 1 WisdonAnderson etal CompanyCORRECTION Contractor

C SW NW

 Ft. from N. Line680 Ft. from S. Line Ft. from E. Line660 Ft. from W. Line

SECTION PLAT

o			

MISCELLANEOUS

Location Rig up Drilling and Remarks: Reported

C SW SW

RECORD

Cased in., ft.Sand Gas Oil Total Depth

PRODUCTION

1st 24 hrs. Nat. 1st 24 hrs. after shot Gas Cu. Ft.Dry Hole Abandoned

Date

AUG 6 1941 19 S. J. LEWIS Scout

Map No. NM Sec. 29 Twp. 9 R. 20EWell No. 1 Wisdon

Anderson etal

Company

Contractor

COMPLETED

C SW NW

Ft. from N. Line

680

Ft. from S. Line

Ft. from E. Line

660

Ft. from W. Line

SECTION PLAT

0			

MISCELLANEOUS

Location _____

Rig up _____

Drilling and Remarks:

Buile 1430

6 1/2 @ 2440

Rock Press. 505

15 1/4 m gas

C

RECORD

Cased _____ in., _____ ft.

Sand _____

Gas _____

Oil _____

Total Depth ~~7444~~ 1453

PRODUCTION

1st 24 hrs. Nat. _____

1st 24 hrs. after shot _____

Gas _____ Cu. Ft.

Dry Hole _____

Abandoned _____

Date

AUG 13 1941

19

S. J. LEWIS

Scout