


Section 29 Township 9 Range 20-E

Well No. #1 Woodhead

Company Hatcher Fisk

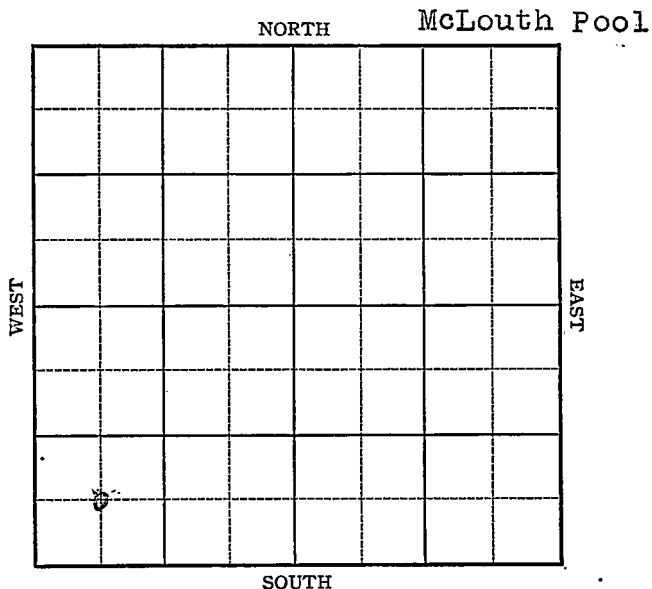

Sec 29 Twp. 9 R. 20-E

Well No. #1. Woodhead Farm

Hatcher Fisk Company


(McLouth)

\_\_\_\_\_ Ft. from N. Line

660 Ft. from S. Line

\_\_\_\_\_ Ft. from E. Line

660 Ft. from W. Line

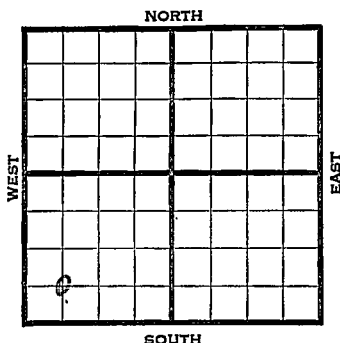

1942	REPORT
4/8	10" - 73' Drlg. 80'
4/15	908' run 8".
4/22	8" - 908' 6" - 1322'
	Sand 1478-83' T.D.
	Shut down.
4/29	SD 1520'
5/6	6" - 1475' Shot 60 qts.
	900' oil 3 hours.
5/13	" " "
5/20	" " "
5/27	Sand 1478'
	6" - 1479'
	T.D. 1520'
	Shot 60 qts. 1485-1511'
	Pump 32 oil.
	<del>XX</del> 25. Gravity
	<b>COMPLETED</b>

Map No. MM Sec. 29 Twp. 9 R. 20EWell No. 1 Woodhead

Hatcher Fisk Company

**FIRST REPORT**

Contractor

C SW SW

## SECTION PLAT

o			

\_\_\_\_\_ Ft. from N. Line

660 Ft. from S. Line

\_\_\_\_\_ Ft. from E. Line

660 Ft. from W. Line

## MCLOUTH POOL

Location \_\_\_\_\_

Rig up \_\_\_\_\_

Drilling and Remarks:

10" - 73'

Drlg. 80'

## RECORD

Cased \_\_\_\_\_ in., \_\_\_\_\_ ft.

Sand \_\_\_\_\_

Gas \_\_\_\_\_

Oil \_\_\_\_\_

Total Depth \_\_\_\_\_

## PRODUCTION

1st 24 hrs. Nat. \_\_\_\_\_

1st 24 hrs. after shot \_\_\_\_\_

Gas \_\_\_\_\_ Cu. Ft.

Dry Hole \_\_\_\_\_

Abandoned \_\_\_\_\_

Date

APR 8 1942S. J. LEWIS Scout

