

KANSAS

FORM 51 5M 10-41 PETROL

Jefferson

Section 29 Township 9 Range 20-E

Well No. #2 Schrader


Company Hatcher & Fisk

(McLouth)

NORTH

WEST

EAST

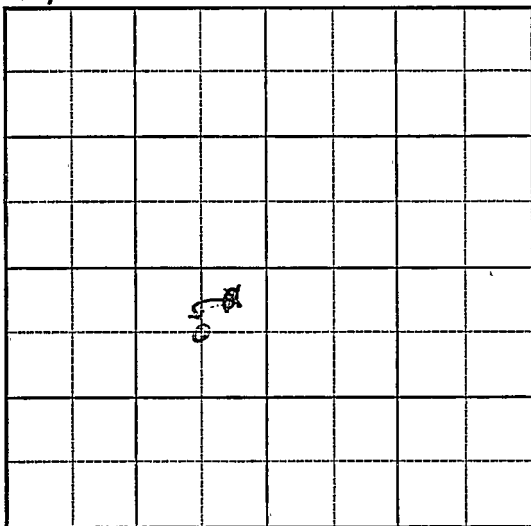

SOUTH

Sec. 29 Twp. 9 R. 20-E

Well No. #2 Schrader Farm

Hatcher & Fisk Company

(McLouth)


~~660330~~ Ft. from N. Line

_____ Ft. from S. Line

660

~~550~~ Ft. from E. Line

Ft. from W. Line

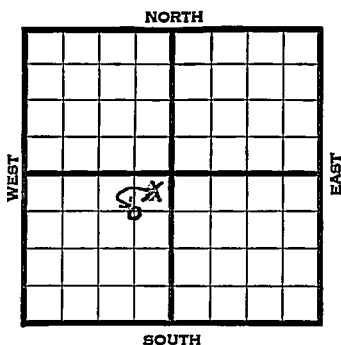

	REPORT
1941	
12/10	10" - 60'
	Drilling 130'.
12/18	8" @ 913 Drlg. 950'
12/24	Drlg. 1365'
12/31	Sand 1473' Gas 1477' T.D.
	Run casing.
1942	
1/8	5" - 1477' T.D. 1495'
	1½ M gas.
1/14	Sand 1488'
	5" - 1477'
	T.D. 1495'
	P.B. to 1490'
	1½ M gas.
	COMPLETED

Map No. NM Sec. 29 Twp. 9 R. 20EWell No. 2 SchraderHatcher & Fisk CompanyFIRST REPORT Contractor

NE SW

SECTION PLAT

	o		

330 Ft. from N. Line Ft. from S. Line330 Ft. from E. Line Ft. from W. LineMcLOUTH POOL

RECORD

Location Rig up

Drilling and Remarks:

10" - 60'Drilling 130'Cased in., ft.Sand Gas Oil Total Depth

PRODUCTION

1st 24 hrs. Nat. 1st 24 hrs. after shot Gas Cu. Ft.Dry Hole Abandoned

Date

DEC 10 1941 19 S. J. LEWIS Scout

Jefferson


KANSAS

Map No. NM Sec. 29 Twp. 9 R. 20EWell No. 2 SchraderHatcher & Fisk Company

Contractor

C NE SW

SECTION PLAT

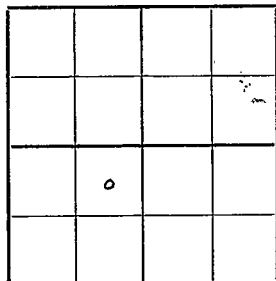660 Ft. from N. Line Ft. from S. Line660 Ft. from E. Line Ft. from W. Line

MCLOUTH POOL

RECORD

Location Cased in., ft.Rig up Sand

Drilling and Remarks:

Gas Oil Total Depth

Reported

PRODUCTION

NE SW

1st 24 hrs. Nat. 1st 24 hrs. after shot Gas Cu. Ft.Dry Hole Abandoned

Date

JAN 7 1942 19 S. J. LEWIS Scout

Jefferson

KANSASMap No. MM Sec. 29 Twp. 9 R. 20EWell No. 2 SchraderHatcher & Fisk Company**COMPLETED** Contractor

C NE SW

SECTION PLAT

	0		

660 Ft. from N. Line Ft. from S. Line660 Ft. from E. Line Ft. from W. Line**MCLOUTH POOL**Location Rig up

Drilling and Remarks:

*Sand 1488**5" C 1477**PB 1490**1 1/2 M Gas***RECORD**Cased in., ft.Sand Gas Oil Total Depth 1495**PRODUCTION**1st 24 hrs. Nat. 1st 24 hrs. after shot Gas Cu. Ft.Dry Hole Abandoned

Date

JAN 14 1942 19S. J. LEWIS Scout