

Clay

KANSAS


SECTION 3 TOWNSHIP 9 RANGE 4E

WELL NO. #2 F.L. Griffith

COMPANY Pure Oil

NORTH ~~NE~~ ^{NW} SE NW

6

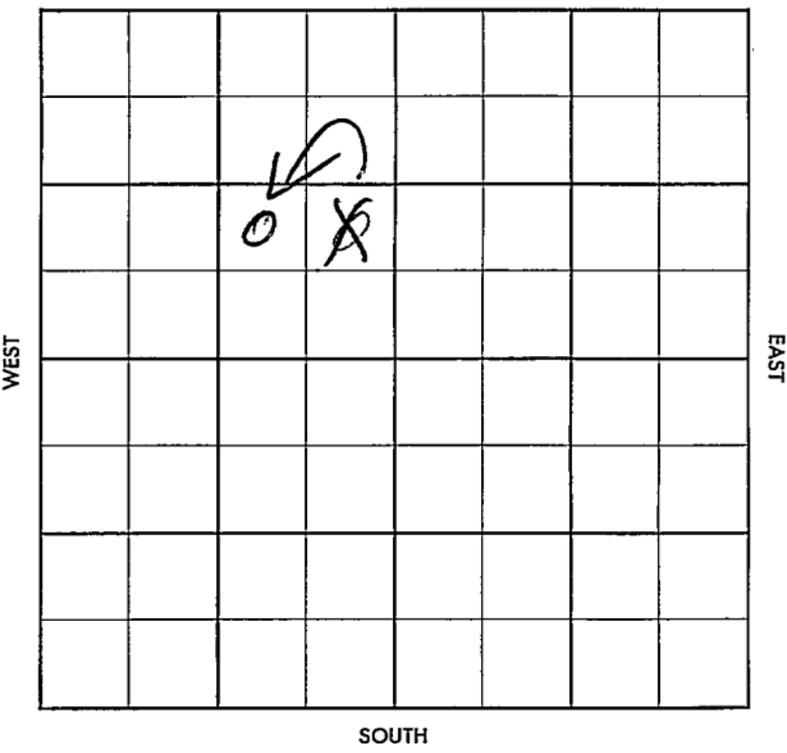

(No County Map)

County Clay Elev. 1306 GF
 Sec. 3 Twp. 9 Rge. 4E
 Company Pure Oil
 Farm Name F. I. Griffith No. 2

TOPS	DEPTH	LOG	DATUM
Anh.			
Tp.			
H.			
Tr.			
Dg.			
Bl.			
L.			
K.C.			
B.K.C.			
Ce.			
C.			
M.			
M.			
K.			
Mz.			
Mq.			
V.			
S.			
S.			
A			
R.			
Pe.			
G.			
T.D.			

Loc. in Sec. NE SE NW
 Geol. _____
 Contr. _____
 Pool Griffith

JUL 10 '57
 FIRST REPORT

Date Comm. _____
 Location _____

Co.
 No.
 Sec.
 T.
 R.

CORRECTION

FORM 513 SUNRAY

Mo County MISS DE

County Clay Elev. 1306 GF
 Sec. 3 Twp. 9 Rge. LE
 Company Pure Oil
 Farm Name F. L. Griffith No. 2

TOPS	DEPTH	LOG	DATUM	Loc in Sec.
Anb.				NE SE NW NW
Tr.				
H.				
Tr.				
Dg.				
Bl.				
L.				Geol.
K.C.				Contr.
B.K.C.				
Ce.				
C.				
M. <u>LI</u>	<u>1953</u>			
M.				Fral
K.				<u>Griffith</u>
Mz.				
Mo.				
V.				
S.				
S.				
A.				
R.				
PE.				
G.				
TR.	<u>2010</u>	<u>2010</u>		COMPLETE

Date Comm.

Location JUL 17 '57 ✓ JUL 24 '57 JUL 31 '57
7-25-57 8 5/8 290/200
930 AUG 9 '57 cld 1959-77 rec
17' cld 1977-84 rec 4'
cld 1986-96 Full rec. DST
1953-2010 1hr rec. 3' Free oil
+ 40' OCM FPO BHP 595/20"
2head. AUG 14 '57 5 1/2 @ 2010/100
MICT 72/1970-84 11/1990-94

~~101~~ Frae 6 X 6. ~~8~~ ~~19~~ ~~130~~
 'Ld + 43 B0² AUG 21 '57 ~~COFF 51.8.110~~
 133 B0 + 4 BW + 198 BSW / 24 hrs. Pup
 10 B0 + 102 BW / 17 hr Gray 27.6.
 AUG 28 '57 P. 51 B0 + 135 BW
 24 hrs) SEP 4 '57 Ph P. 9.3
 Bopd + 6.8 to wta 9 raw
 27.6°

3-9-4E

NW SE NW