

KANSAS


FORM 51 5M 10-41 PETROL

Jefferson

Section 30 Township 9 Range 20-W

Well No. #1 Black

Company Hatcher & Fisk
(McLouth)

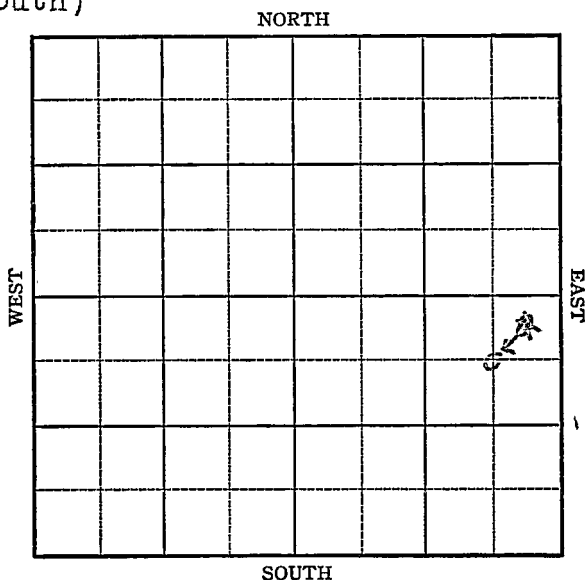

KANSAS

Sec. 30 Twp. 9 Jefferson R. 20-E


Well No. #1 Black Farm
Hatcher & Fisk Company

(McLouth) 660
~~330~~ Ft. from N. Line

_____ Ft. from S. Line

~~330~~ 660
Ft. from E. Line

_____ Ft. from W. Line

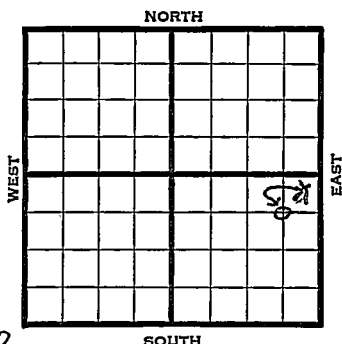

Elv 1098

1941

REPORT

12/10 Machine.

12/18 Spud SD

12/24 10" - 61' T.D. 1100' Run 8".

12/31 8" - 932' 1245' fsg.

1942

1/8 6" - 1307' Drlg. 1310'

1/15 Drlg. 1350'

1/22 Sand 1503-09' SS0.

Miss. 1516-19' T.D.

Shut down.

1/29 TD 1640' SD.

2/4 Miss. 1516'

T.D. 1687'

No shows.

ABANDONED

Map No. MM Sec. 30 Twp. 9 R. 20E
Well No. 1 Black

Hatcher & Fisk Company
FIRST REPORT Contractor

NE SE

SECTION PLAT

			b

330 Ft. from N. Line
____ Ft. from S. Line
330 Ft. from E. Line
____ Ft. from W. Line

McLOUTH POOL

Location _____
Rig up _____
Drilling and Remarks:

Machine

RECORD

Cased _____ in., _____ ft.
Sand _____
Gas _____
Oil _____
Total Depth _____

PRODUCTION

1st 24 hrs. Nat. _____
1st 24 hrs. after shot _____
Gas _____ Cu. Ft.
Dry Hole _____
Abandoned _____

Date

DEC 10 1941 19 S. J. LEWIS Scout

Map No. MM Sec. 30 Twp. 9 R. 20EWell No. 1 BlackHatcher & Fisk CompanyContractor

C NE SE

SECTION PLAT

			o

660 Ft. from N. Line Ft. from S. Line660 Ft. from E. Line Ft. from W. LineMCLOUTH POOL

RECORD

Location Cased in., ft.Rig up Sand

Drilling and Remarks:

Gas Oil Total Depth

Reported

PRODUCTION

NE SE

1st 24 hrs. Nat. 1st 24 hrs. after shot Gas Cu. Ft.Dry Hole Abandoned

Date

JAN 7 1942 19 S. J. LEWIS Scout

Jefferson **KANSAS**Map No. MM Sec. 30 Twp. 9 R. 20EWell No. 1 BlackHatcher & Fisk CompanyABANDONED Contractor

C NE SE

660 Ft. from N. Line Ft. from S. Line660 Ft. from E. Line Ft. from W. Line

SECTION PLAT

			b

MCLOUTH POOL

Location Rig up

Drilling and Remarks:

*Miss 1516**No show.*

RECORD

Cased in., ft.Sand Gas Oil Total Depth 1687

PRODUCTION

1st 24 hrs. Nat. 1st 24 hrs. after shot Gas Cu. Ft.Dry Hole Abandoned

Date

FEB 4 1942 19S. J. LEWIS Scout