

KANSAS

FORM 51 5M 10-41 PETROL


Jefferson

Section 30 Township 9 Range 20-E

Well No. #1 Garrett

Company O. J. Connell

(McLouth)

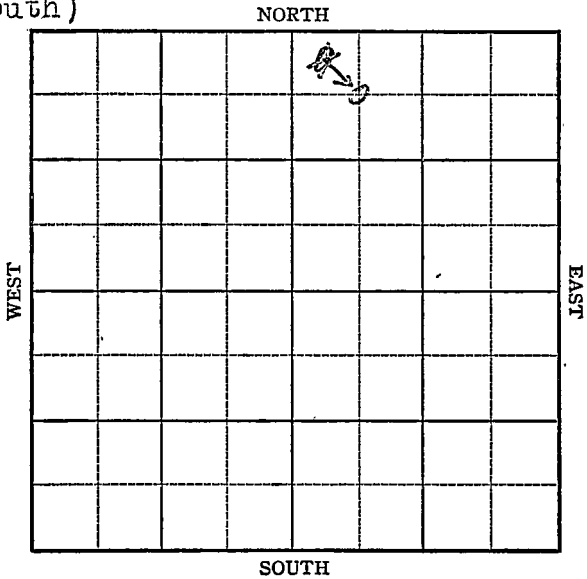

KANSAS

Jefferson

Sec. 30 Twp. 9 R. 20-E

Well No. #1 Garrett Farm

O. J. Connell Company


(McLouth) 660
~~580~~ Ft. from N. Line

_____ Ft. from S. Line

_____ Ft. from E. Line

660
~~530~~ Ft. from W. Line

Elw 1031

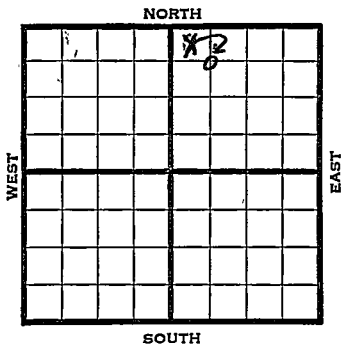

1941	REPORT
12/10	Location.
12/18	"
12/24	Drlg. 100'
12/31	Drlg. 300'
1942	
1/8	SD 450'
1/15	10" - 88' Drlg. 555'
1/22	Drlg. 910'
1/29	8" - 860' Drlg. 1350'
2/5	TD 1730' SD.
2/11	Miss. 1465'
	6" - 1432'
	T.D. 1530'
	No shows.
	ABANDONED

Map No. MM Sec. 30- Twp. 9 R. 20EWell No. 1 GarrettO. J. Connell CompanyFIRST REPORT Contractor

NW NE

330 Ft. from N. Line

_____ Ft. from S. Line

_____ Ft. from E. Line

330 Ft. from W. Line

SECTION PLAT

		o	

McLOUTH POOL

Location XX

Rig up _____

Drilling and Remarks:

RECORD

Cased _____ in., _____ ft.

Sand _____

Gas _____

Oil _____

Total Depth _____

PRODUCTION

1st 24 hrs. Nat. _____

1st 24 hrs. after shot _____

Gas _____ Cu. Ft.

Dry Hole _____

Abandoned _____

Date

DEC 10 1941

19

S. J. LEWIS Scout

Jefferson **KANSAS**Map No. MM Sec. 30 Twp. 9 R. 20EWell No. 1 GarrettO. J. Connell Company

Contractor

C NW NE

660 Ft. from N. Line

_____ Ft. from S. Line

_____ Ft. from E. Line

660 Ft. from W. Line

SECTION PLAT

		o	

MCLOUTH POOL

RECORD

Location _____

Cased _____ in., _____ ft.

Rig up _____

Sand _____

Drilling and Remarks:

Gas _____

Oil _____

Total Depth _____

Reported NW NE

PRODUCTION

1st 24 hrs. Nat. _____

1st 24 hrs. after shot _____

Gas _____ Cu. Ft.

Dry Hole _____

Abandoned _____

Date

JAN 7 1942

19

S. J. LEWIS Scout

Map No. NM Sec. 30 Twp. 9 R. 20EWell No. 1 GarrettO. J. Connell CompanyABANDONED Contractor

C NW NE

SECTION PLAT

		o	

660 Ft. from N. Line

_____ Ft. from S. Line

_____ Ft. from E. Line

660 Ft. from W. LineM CLOUTH POOL

Location _____

Rig up _____

Drilling and Remarks:

*Miss 1465**6" @ 1482.**No shows*

RECORD

Cased _____ in., _____ ft.

Sand _____

Gas _____

Oil _____

Total Depth 1580

PRODUCTION

1st 24 hrs. Nat. _____

1st 24 hrs. after shot _____

Gas _____ Cu. Ft.

Dry Hole _____

Abandoned _____

Date

FEB 11 1942 19S. J. LEWIS Scout