

KANSAS


FORM 51 5M 1-42 PETROL

Jefferson

Section 31 Township 9 Range 19-E

Well No. #1 Snyder

Company Sagamore

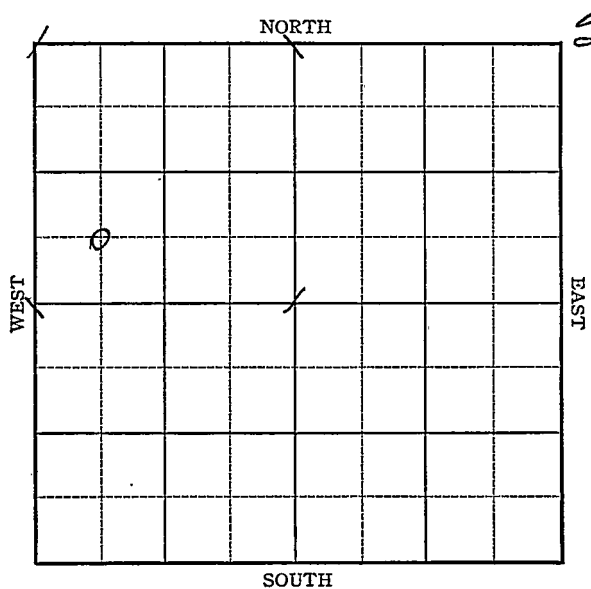


LES 998

KANSAS

Jefferson

Sec. 31 Twp. 9 R. 19-EWell No. #1 Snyder FarmSagamore Company

McLouth

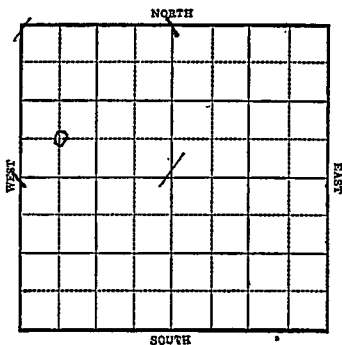 Ft. from N. Line660 Ft. from S. Line Ft. from E. Line660 Ft. from W. Line

1943	R E P O R T
6/2	Location.
6/9	"
6/16	Machine
6/23	"pud
6/30	"
7/7	13" @ 42' 10" @ 575 8" @ 1243' SD
7/15	8" @ 1252 T.D. 1380' SD
7/21	Sand 1520 Miss 1555 T.D. 1556 6" @ 1556 CO
7/28	Miss. 1555 6" @ 1556' T.D. 1726'
	ABANDONED

Jefferson

KANSAS

Map No. NM Sec. 31 Twp. 9 R. 19EWell No. 1 SnyderSagamore


Company

ABANDONED

Contractor

C SW NW

SECTION PLAT

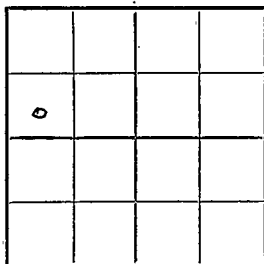

_____ Ft. from N. Line

660 Ft. from S. Line

_____ Ft. from E. Line

660 Ft. from W. Line

MCLOUTH POOL

Location _____

Rig up _____

Drilling and Remarks:

His 15556 " @ 1556

RECORD

Cased _____ in., _____ ft.

Sand _____

Gas _____

Oil _____

Total Depth 1726

PRODUCTION

1st 24 hrs. Nat. _____

1st 24 hrs. after shot _____

Gas _____ Cu. Ft.

Dry Hole _____

Abandoned _____

Date

JUL 28 1943 19S. J. LEWIS Scout


KANSASMap No. MM Sec. 31 Twp. 9 R. 19EWell No. 1 SnyderSagamore

Company

FIRST REPORT

Contractor

C SW NW

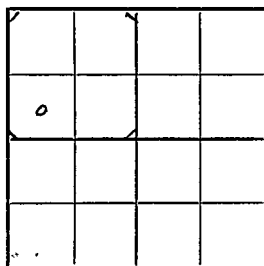SECTION PLAT Ft. from N. Line660 Ft. from S. Line Ft. from E. Line660 Ft. from W. Line**MCLOUTH POOL**Location XXXRig up

Drilling and Remarks:

RECORDCased in, ft.Sand Gas Oil Total Depth **PRODUCTION**1st 24 hrs. Nat. 1st 24 hrs. after shot Gas Cu. Ft.Dry Hole Abandoned

Date

JUN 2 1943

19

S. J. LEWIS

Scout