

KANSAS


Leavenworth

FORM 51 5M 1-42 PETROL

Section 31 Township 9 Range 21E

Well No. #1 Powell

Company Chas Miller

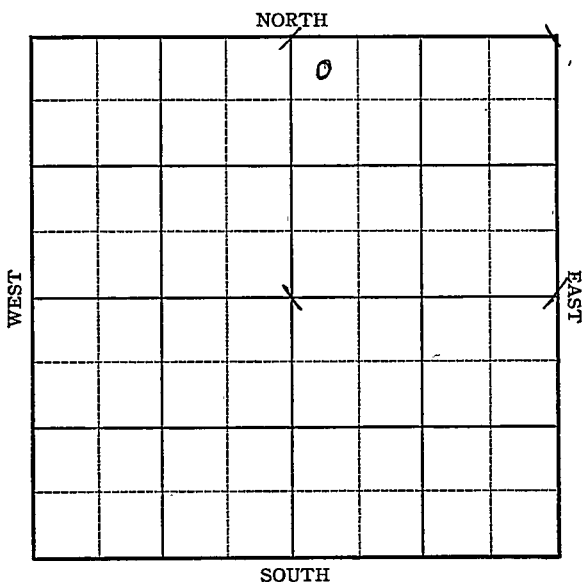

KANSAS

Leavenworth

Sec. 31 Twp. 9 R. 21-E

Well No. #1 Powell Farm

Chas Miller Company


McLouth

330 Ft. from N. Line

 Ft. from S. Line

 Ft. from E. Line

330 Ft. from W. Line

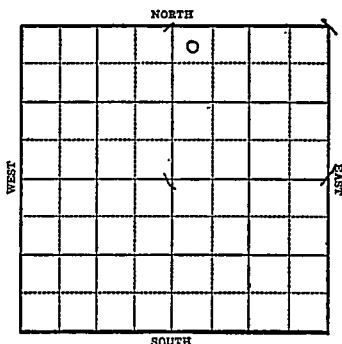

1943

R E P O R T

7/21

Location.

7/28

630 SD for csg

8/4

10" @ 633'

6" @ 1057

Sand 1258-59

Miss 1259

SO 1259-64

Drlg. 1504'

8/11

" "

8/18

Miss 1259

HPW

T.D. 1424'

ABANDONED

KANSAS

Map No. 1111 Sec. 31 Twp. 9 R. 21EWell No. 1 PowellChas Miller CompanyFIRST REPORT Contractor

SECTION PLAT


330 NW NE
Ft. from N. Line

Ft. from S. Line

Ft. from E. Line

330 Ft. from W. Line

McLouth Pool.

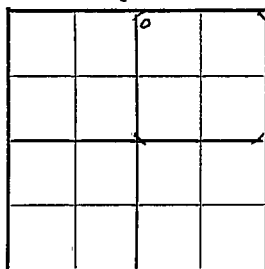Location X

Rig up

Drilling and Remarks:

RECORD

Cased _____ in., _____ ft.

Sand _____

Gas _____

Oil _____

Total Depth _____

PRODUCTION

1st 24 hrs. Nat. _____

1st 24 hrs. after shot _____

Gas _____ Cu. Ft.

Dry Hole _____

Abandoned _____

Date

JUL 21 1943 19S. J. LEWIS Scout

Map No. **KANSAS** Sec. **31** Twp. **9** R. **21E**

Well No. **1 Powell**

Chas. Miller

Company

ABANDONED

Contractor

NW NE

SECTION PLAT

330 Ft. from N. Line

Ft. from S. Line

Ft. from E. Line

330 Ft. from W. Line

McLouth Pool

		o	

Location

Rig up

Drilling and Remarks:

11/12/59

HPW.

RECORD

Cased _____ in., _____ ft.

Sand _____

Gas _____

Oil _____

Total Depth **1424**

PRODUCTION

1st 24 hrs. Nat. _____

1st 24 hrs. after shot _____

Gas _____ Cu. Ft.

Dry Hole _____

Abandoned _____

Date

AUG 18 1943

19

S. J. LEWIS Scout,