

KANSAS

Jefferson


FORM 51 5M 4-41 PETROL


Section 32 Township 9 Range 20E

Well No. 1 Brose

Company Longwell et al

Miscellaneous

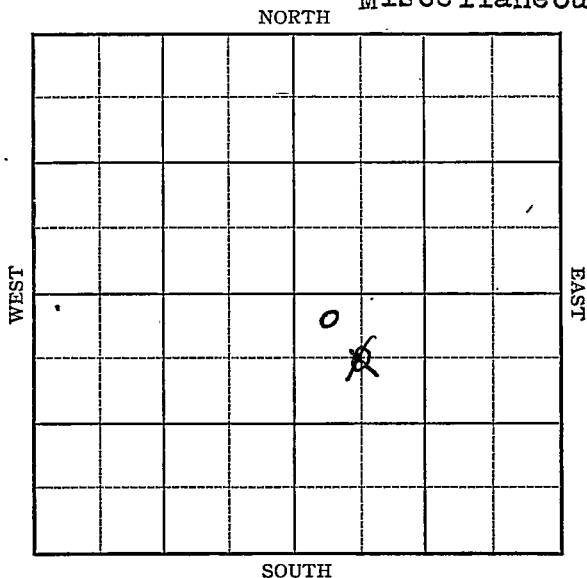

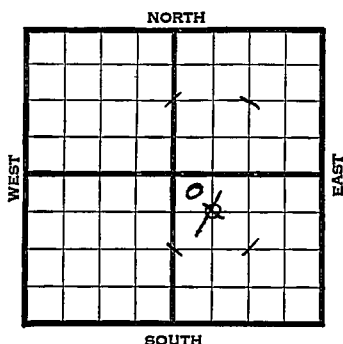
[illegible]

Map No. NM Sec. 32 Twp. 9 R. 20EWell No. 1 BroseLongwell etal CompanyFIRST REPORT Contractor

C NW SE

660 Ft. from N. Line Ft. from S. Line Ft. from E. Line660 Ft. from W. Line


SECTION PLAT

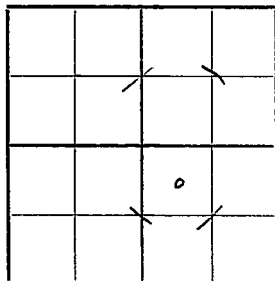

MISCELLANEOUS

Location Rig up

Drilling and Remarks:

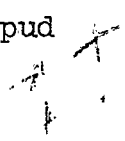Spud 

RECORD

Cased in., ft.Sand Gas Oil Total Depth

PRODUCTION

1st 24 hrs. Nat. 1st 24 hrs. after shot Gas Cu. Ft.Dry Hole Abandoned

Date

AUG 13 1941 19S. J. LEWIS Scout

KANSAS

Map No. _____ Sec. 32 Twp. 9 R. 20E

Well No. 1 Brose

Longwell et al

Company

CORRECTION

Contractor

SECTION PLAT

NW SE

330 Ft. from N. Line

Ft. from S. Line

Ft. from E. Line

330 Ft. from W. Line

		o	

MISCELLANEOUS

Location _____

Rig up _____

Drilling and Remarks:

Reported

C NW SE

RECORD

Cased _____ in., _____ ft.

Sand _____

Gas _____

Oil _____

Total Depth _____

PRODUCTION

1st 24 hrs. Nat. _____

1st 24 hrs. after shot _____

Gas _____ Cu. Ft.

Dry Hole _____

Abandoned _____

Date

AUG 27 1941

19

S. J. LEWIS

Scout

Map No. — Sec. 32 Twp. 9 R. 20EWell No. 1 BroseLongwell et al CompanyCOMPLETED Contractor

SECTION PLAT

NW SE

330 Ft. from N. Line— Ft. from S. Line— Ft. from E. Line330 Ft. from W. Line

		0	

MISCELLANEOUS

Location —Rig up —

Drilling and Remarks:

*Bar 8. 1485**6" @ 1488**3,360,000 @ 1488**Bar*

RECORD

Cased — in., — ft.Sand —Gas —Oil —Total Depth 1518

PRODUCTION

1st 24 hrs. Nat. —1st 24 hrs. after shot —Gas — Cu. Ft.Dry Hole —Abandoned —

Date

SEP 24 1941

19

S. J. LEWIS Scout