

KANSAS

Jefferson

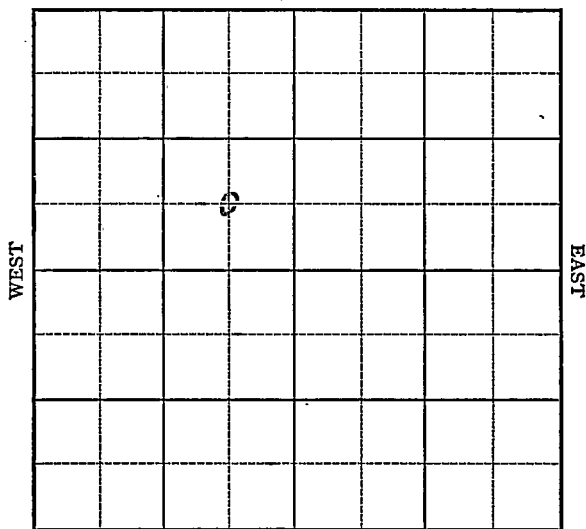
FORM 51 5M 4-41 PETROL

Section 32 Township 9 Range 20-E

Well No. #1 Fowler

Company Hatcher & ~~Risk~~ ^{Fisk}

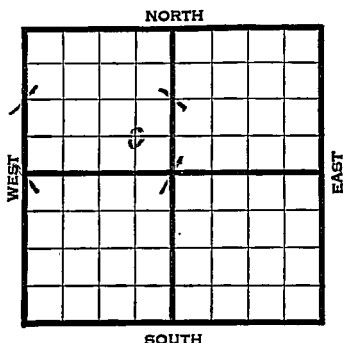
NORTH Miscellaneous



SOUTH

Sec. 32 Twp. 9 R. 20-EWell No. #1 Fowler FarmHatcher & Risk Fisk Company

(Misc.)

 Ft. from N. Line660 Ft. from S. Line660 Ft. from E. Line Ft. from W. Line

1941	REPORT
10/8	Location
10/16	Machine.
10/23	10" - 62' Drlg. 675'
10/30	8" - 930' Drlg. 1375'
11/6	1400' fishing.
11/13	" " "
11/20	" " "
11/26	" " "
12/4	" " "
12/11	" " "
12/18	5" @ 1368 Drlg. 3175
12/24	Drlg. 1422'
12/31	Drlg. 1478'
1942	
1/7	Miss. 1440'
	T.D. 1444'
	No shows.
	ABANDONED

Jefferson

KANSAS

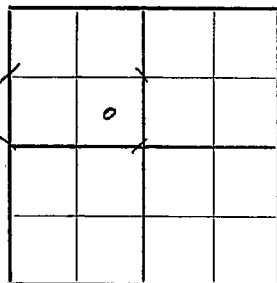
Map No. NM Sec. 32 Twp. 9 R. 20EWell No. 1 FowlerHatcher & Risk

Company

FIRST REPORT

Contractor

C SE NW

 Ft. from N. Line660 Ft. from S. Line660 Ft. from E. Line Ft. from W. Line**SECTION PLAT****MISCELLANEOUS**Location Rig up Drilling and Remarks: **RECORD**Cased in., ft.Sand Gas Oil Total Depth **PRODUCTION**1st 24 hrs. Nat. 1st 24 hrs. after shot Gas Cu. Ft.Dry Hole Abandoned

Date

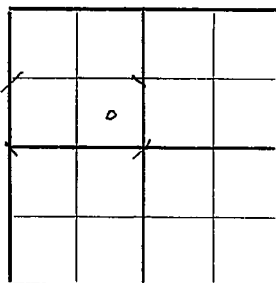
OCT 8 1941 19S. J. LEWIS

Scout

Map No. NM Sec. 32 Twp. 9 R. 20EWell No. 1 FowlerHatcher & Fisk CompanyCORRECTION Contractor

SECTION PLAT

C SE NW

 Ft. from N. Line660 Ft. from S. Line660 Ft. from E. Line Ft. from W. Line

MISCELLANEOUS

Location Rig up

Drilling and Remarks:

Reported as
Hatcher & Fisk

RECORD

Cased in., ft.Sand Gas Oil Total Depth

PRODUCTION

1st 24 hrs. Nat. 1st 24 hrs. after shot Gas Cu. Ft.Dry Hole Abandoned

Date

Oct 15 1941S. J. LEWIS

Scout

Map No. NM Sec. 32 Twp. 9 R. 20EWell No. 1 FowlerHatcher & Fisk CompanyABANDONED Contractor

C SE NW

SECTION PLAT

	6		

 Ft. from N. Line660 Ft. from S. Line660 Ft. from E. Line Ft. from W. Line

MISCELLANEOUS

Location Rig up

Drilling and Remarks:

*Miss 1440**Noe holes*

RECORD

Cased in., ft.Sand Gas Oil Total Depth 1444

PRODUCTION

1st 24 hrs. Nat. 1st 24 hrs. after shot Gas Cu. Ft.Dry Hole Abandoned

Date

JAN 7 1942 19 S. J. LEWIS Scout