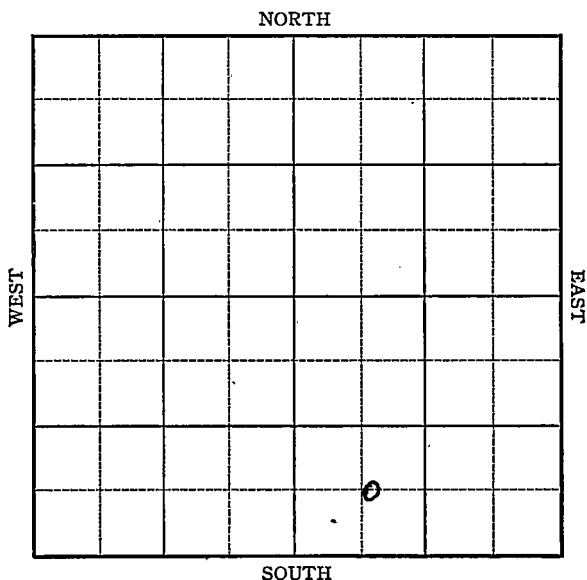
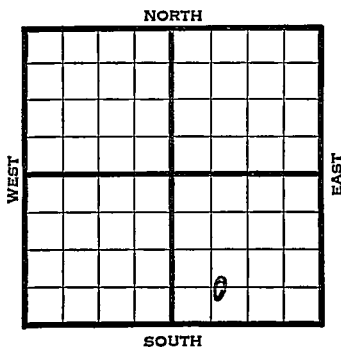


Jefferson

KANSAS

Section 32 Township 9 Range 20EWell No. 1 HarrisCompany Magnolia

[illegible]

Map No. NM Sec. 32 Twp. 9 R. 20EWell No. 1 HarrisMagnolia

Company

FIRST REPORT

Contractor

SECTION PLAT

C SW SE

Ft. from N. Line

660

Ft. from S. Line

Ft. from E. Line

760

Ft. from W. Line

MISCELLANEOUS

Location X

Rig up

Drilling and Remarks:

RECORD

Cased _____ in., _____ ft.

Sand _____

Gas _____

Oil _____

Total Depth _____

PRODUCTION

1st 24 hrs. Nat. _____

1st 24 hrs. after shot _____

Gas _____ Cu. Ft.

Dry Hole _____

Abandoned _____

Date

JUN 18 194119S. J. LEWISScout

Map No. NM Sec. 32 Twp. 9 R. 20EWell No. 1 HarrisMagnolia Company Contractor**COMPLETED**

C SW SE

 Ft. from N. Line660 Ft. from S. Line Ft. from E. Line760 Ft. from W. Line**SECTION PLAT**

		0	

MISCELLANEOUSLocation Rig up

Drilling and Remarks:

*Bar 8 1430**5" @ 1430**12 1/2" H. Gas.**933 B.T.U.***RECORD**Cased in., ft.Sand Gas Oil Total Depth 1450**PRODUCTION**1st 24 hrs. Nat. 1st 24 hrs. after shot Gas Cu. Ft.Dry Hole Abandoned

Date

JUL 30 1941 19S. J. LEWIS Scout