

KANSAS


Jefferson

FORM 51 5M 4-41 PETROL

Section 32 Township 9 Range 20-E

Well No. #2 Brosa

Company McLaughlin

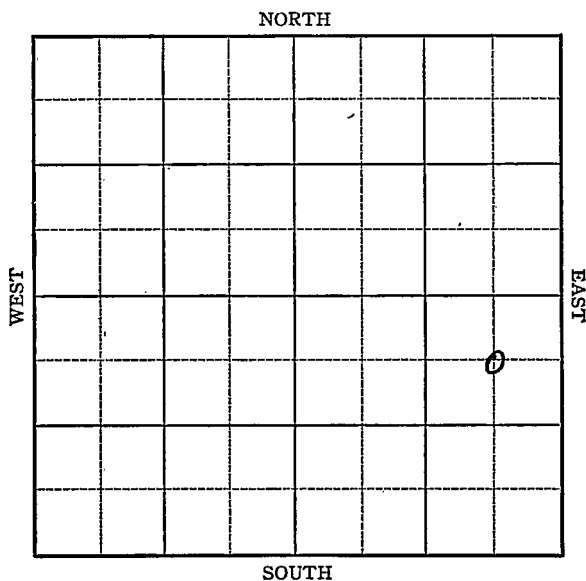


Sec. 32 Twp. 9 R. 20-EWell No. #2 Brosa FarmMcLaughlin Company

(Misc.)

660 Ft. from N. Line Ft. from S. Line660 Ft. from E. Line Ft. from W. Line

Elev. 1084

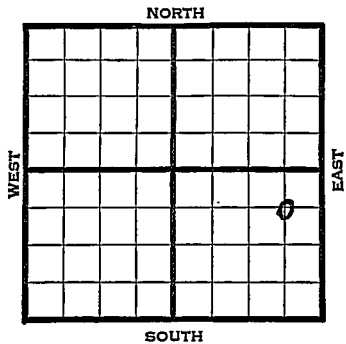

1941

REPORT

7/1

Location

7/10

"

7/17

10" - 30' Drlg. 300'

7/24

Drlg. 780

7/31

8" @ 945'

Drlg. 1258'

8/7

6" @ 1249' Bart 1460' 5" @ 1459'

Drlg. 1464' $\frac{1}{2}$ M Gas.

8/13

Bart. 1460-63'

5" - 1459'

Miss. 1515'

T.D. 1575'

1,070,000 gas.

COMPLETED

Map No. NM Sec. 32 Twp. 9 R. 20EWell No. 2 BrosaMcLaughlin CompanyFIRST REPORT Contractor

C NE SE

SECTION PLAT

660 Ft. from N. Line Ft. from S. Line660 Ft. from E. Line Ft. from W. Line

			o

MISCELLANEOUS

Location XRig up

Drilling and Remarks:

RECORD

Cased in., ft.Sand Gas Oil Total Depth

PRODUCTION

1st 24 hrs. Nat. 1st 24 hrs. after shot Gas Cu. Ft.Dry Hole Abandoned

Date

JUL 1 1941 19 S. J. LEWIS Scout

Map No. NM Sec. 32 Twp. 9 R. 20EWell No. 2 BrosaMcLaughlin

Company

Contractor

COMPLETED**SECTION PLAT**660 C NE SE
Ft. from N. Line

Ft. from S. Line

660 Ft. from E. Line

Ft. from W. Line

			0

MISCELLANEOUS

Location

Rig up

Drilling and Remarks:

*Brill 1460-63**5" 1489**2115 1515**1,070,000.90**@***RECORD**

Cased _____ in., _____ ft.

Sand _____

Gas _____

Oil _____

Total Depth 1575**PRODUCTION**

1st 24 hrs. Nat. _____

1st 24 hrs. after shot _____

Gas _____ Cu. Ft.

Dry Hole _____

Abandoned _____

Date

AUG 13 1941

19

S. J. LEWIS

Scout