

KANSAS


FORM 51 5M 4-41 PETROL

Section 32 Township 9 Range 20-E

Well No. #1 Myers

Company Magnolia

(Misc.)

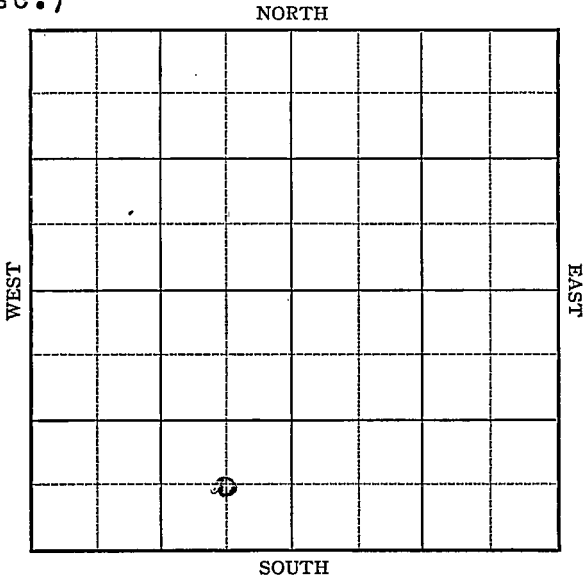

KANSAS

Map No. Sec. 32 Twp. 9 R. 20E

Well No. 1 Myers

Magnolia Company

FIRST REPORT Contractor

C SE SW


_____ Ft. from N. Line

660 Ft. from S. Line

660 Ft. from E. Line

_____ Ft. from W. Line

SECTION PLAT

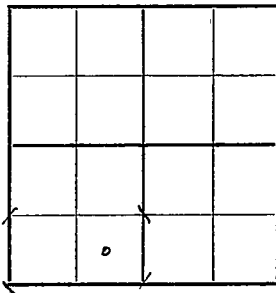

MISCELLANEOUS

Location _____

Rig up _____

Drilling and Remarks:

Machine Spud

RECORD

Cased _____ in., _____ ft.

Sand _____

Gas _____

Oil _____

Total Depth _____

PRODUCTION

1st 24 hrs. Nat. _____

1st 24 hrs. after shot _____

Gas _____ Cu. Ft.

Dry Hole _____

Abandoned _____

Date _____

AUG 6 1941

S. J. LEWIS Scout

