

KANSAS


Jefferson

FORM 51 5M 4-41 PETROL

Section 32 Township 9 Range 20-E

Well No. #1 Schrader


Company E. Jackson
(Misc.)

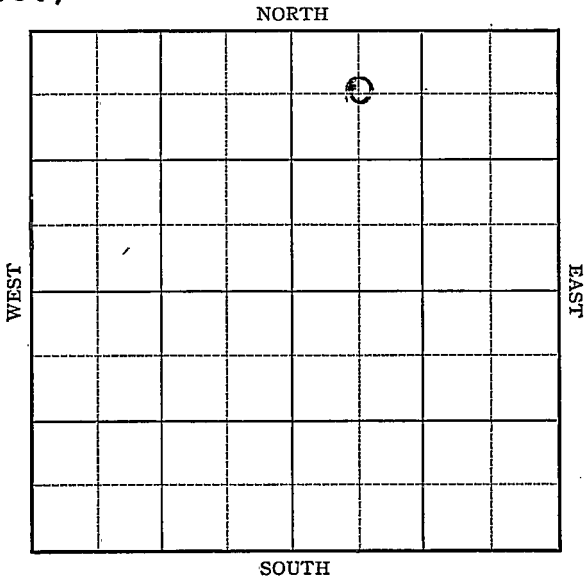

E. Jackson _____ Company
(Miscellaneous) NORTH

660 Ft. from W. Line

Elev. 1088

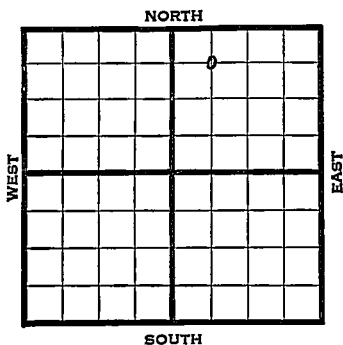[illegible]

KANSASMap No. MM Sec. 32 Twp. 9 R. 20EWell No. 1 SchraderE. Jackson

Company

FIRST REPORT

Contractor

SECTION PLAT

C NW NE

660

Ft. from N. Line

Ft. from S. Line

Ft. from E. Line

660

Ft. from W. Line

		o	

MISCELLANEOUS

Location

Rig up

Drilling and Remarks:

Machine 640

RECORD

Cased _____ in., _____ ft.

Sand

Gas

Oil

Total Depth

PRODUCTION

1st 24 hrs. Nat.

1st 24 hrs. after shot

Gas _____ Cu. Ft.

Dry Hole

Abandoned

Date

AUG 6 1941 19S. J. LEWIS

Scout

Map No. NM Sec. 32 Twp. 9 R. 20EWell No. 1 SchraderE. Jackson

Company

ABANDONED

Contractor

C NW NE

660 Ft. from N. Line Ft. from S. Line Ft. from E. Line660 Ft. from W. Line

MISCELLANEOUS

SECTION PLAT

Location Rig up

Drilling and Remarks:

*Miss 1521**Noah now*

RECORD

Cased in., ft.Sand Gas Oil Total Depth 1600

PRODUCTION

1st 24 hrs. Nat. 1st 24 hrs. after shot Gas Cu. Ft.Dry Hole Abandoned

Date

AUG 20 1941 19S. J. LEWIS

Scout