


Section 32 Township 9 Range 20-E

Well No. #1 Schroeder

Company J. Kilness

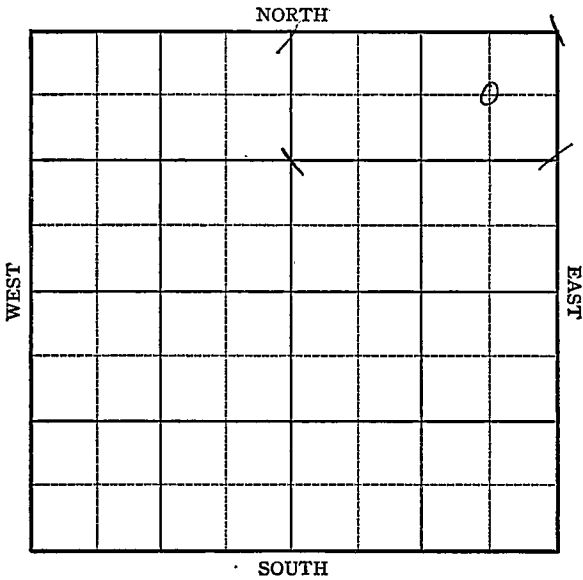

Sec. 32 Twp. 9 R. 20-E

Well No. #1 Schroeder Farm

J. Kilness Company


McLouth Pool

660 Ft. from N. Line

 Ft. from S. Line

660 Ft. from E. Line

 Ft. from W. Line

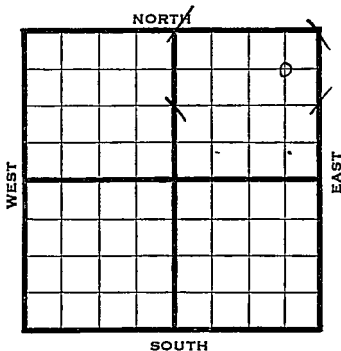

1942

REPORT

12/29

Machine

1943

1/6

10" Casing set at 60'

Drlg. 575'

1/13

915' Run 8"

1/20

Sand 1467

S. S. Gas

6" Casing det 1468'

Miss 1510

No show

TD 1520'


ABANDONED

Jefferson

KANSAS
Map No. MM Sec. 32 Twp. 9 R. 20EWell No. 1 SchroederJ. Kilness CompanyFIRST REPORT Contractor

C NE NE

SECTION PLAT

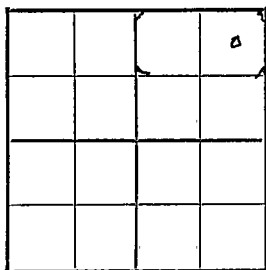660 Ft. from N. Line Ft. from S. Line660 Ft. from E. Line Ft. from W. Line

MCLOUTH POOL

Location _____

Rig up _____

Drilling and Remarks:

Machine _____

RECORD

Cased _____ in., _____ ft.

Sand _____

Gas _____

Oil _____

Total Depth _____

PRODUCTION

1st 24 hrs. Nat. _____

1st 24 hrs. after shot _____

Gas _____ Cu. Ft.

Dry Hole _____

Abandoned _____

Date

DEC 29 1942 19S. J. LEWIS Scout

KANSAS

Map No. N/M Sec. 32 Twp. 9 R. 20E

Well No. 1 Schroeder

J. Kilness Company

ABANDONED Contractor

C NE NE

660 Ft. from N. Line

_____ Ft. from S. Line

660 Ft. from E. Line

_____ Ft. from W. Line

SECTION PLAT

			o

MCLOUTH POOL

Location _____

Rig up _____

Drilling and Remarks:

Sand 1467
S.S. Gas.
6" C 1468
Miss 1510
No show

RECORD

Cased _____ in., _____ ft.

Sand _____

Gas _____

Oil _____

Total Depth 1520

PRODUCTION

1st 24 hrs. Nat. _____

1st 24 hrs. after shot _____

Gas _____ Cu. Ft.

Dry Hole _____

Abandoned _____

Date

JAN 20 1943 19

S. J. LEWIS Scout