

KANSAS


Form 51-5M-7-40-Palace

Jefferson

Section 33 Township 9 Range 20-E

Well No. #1 Bartlett

Company McLaughlin & Son

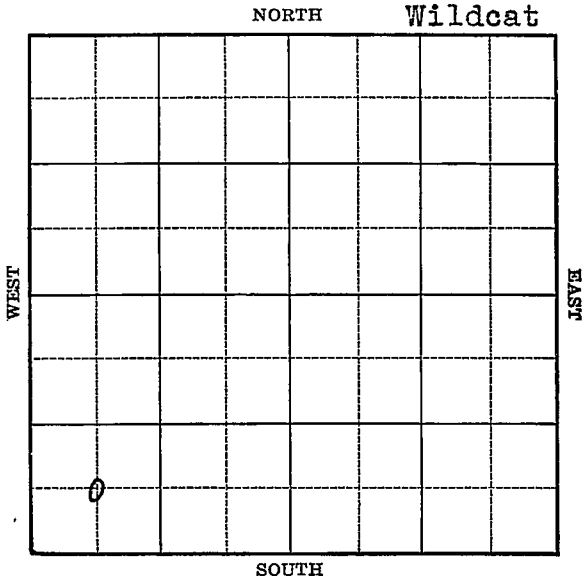

Map No. NM Sec. 33 Twp. 9 R. 20EWell No. 1 BartlettMcLaughlin & Son

Company

FIRST REPORT

Contractor

SECTION PLAT

C SW SW

Ft. from N. Line

660 Ft. from S. Line

Ft. from E. Line

660 Ft. from W. Line

WILDCAT

0			

Location _____

Rig up _____

Drilling and Remarks:
Material**RECORD**

Cased _____ in., _____ ft.

Sand _____

Gas _____

Oil _____

Total Depth _____

PRODUCTION

1st 24 hrs. Nat. _____

1st 24 hrs. after shot _____

Gas _____ Cu. Ft.

Dry Hole _____

Abandoned _____

Date

MAR 19 1921 19S. J. LEWIS Scout

Map No. NM Sec. 33 Twp. 9 R. 20EWell No. 1 BartlettMcLaughlin & Son

Company

~~COMPLETED~~

Contractor

SECTION PLAT

C SW SW

 Ft. from N. Line660 Ft. from S. Line Ft. from E. Line660 Ft. from W. Line

o			

WILDCAT

Location Rig up

Drilling and Remarks:

*Bar 8. 1396.**7" C 1394.**7 1/2 M Gas***RECORD**Cased in., ft.Sand Gas Oil Total Depth 1430**PRODUCTION**1st 24 hrs. Nat. 1st 24 hrs. after shot Gas Cu. Ft.Dry Hole Abandoned

Date

APR 23 1941 19S. J. LEWIS Scout