

Jefferson


FORM 51 5M 4-41 PETROL


KANSAS

Section 33 Township 9 Range 20E

Well No. #1 Bartlett

Company Longwell et al

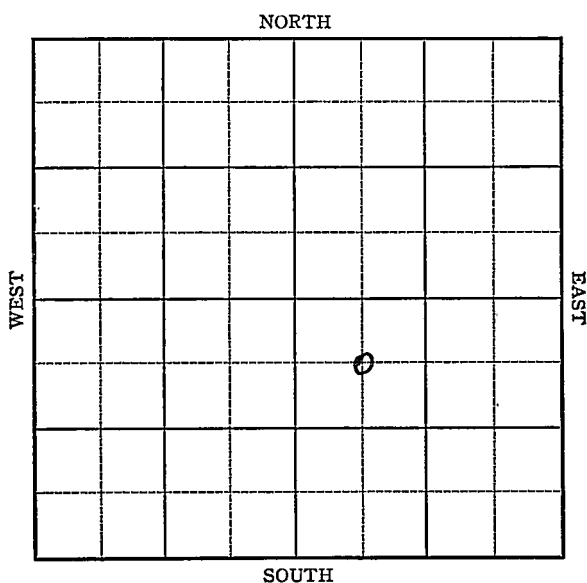

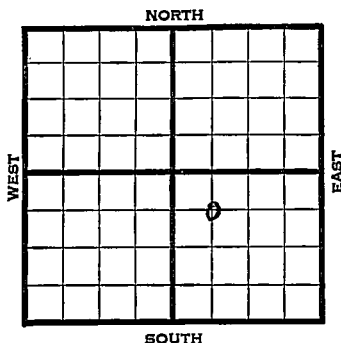[illegible]

Map No. NM Sec. 33 Twp. 9 R. 20EWell No. 1 BartlettLongwell etal

Company

Contractor

FIRST REPORT

C NW SE

660 Ft. from N. Line Ft. from S. Line Ft. from E. Line660 Ft. from W. Line**MISCELLANEOUS****SECTION PLAT**

		o	

Location Rig up

Drilling and Remarks:

Drlg., 475**RECORD**Cased in., ft.Sand Gas Oil Total Depth **PRODUCTION**1st 24 hrs. Nat. 1st 24 hrs. after shot Gas Cu. Ft.Dry Hole Abandoned

Date

JUL 16 194119S. J. LEWIS Scout

KANSASMap No. NM Sec. 33 Twp. 9 R. 20EWell No. 1 BartlettLongwell etal CompanyCOMPLETED Contractor

SECTION PLAT

		o	

660 C NW SE
Ft. from N. Line

Ft. from S. Line

Ft. from E. Line

660 Ft. from W. Line

MISCELLANEOUS

Location _____

Rig up _____

Drilling and Remarks:

*Bar 1435**6' @ 1436**5 1/2 M Gas**930 BTU*

RECORD

Cased _____ in., _____ ft.

Sand _____

Gas _____

Oil _____

Total Depth 1462

PRODUCTION

1st 24 hrs. Nat. _____

1st 24 hrs. after shot _____

Gas _____ Cu. Ft.

Dry Hole _____

Abandoned _____

Date

JUL 30 1941 19 S. J. LEWIS Scout