


# KANSAS Jefferson

FORM 51 5M 4-41 PETROL

Section 33 Township 9 Range 20-E

Well No. #2 Bartlett

Company Longwell et al  
(Misc.)

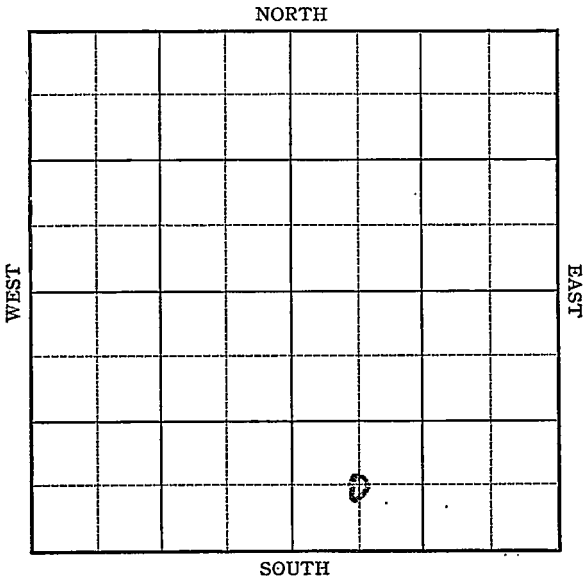

Sec. 33 Twp. 9 R. 20-E

Well No. #2 Bartlett Farm

Longwell et al Company

(Miscellaneous)

\_\_\_\_\_ Ft. from N. Line

660


\_\_\_\_\_ Ft. from S. Line

\_\_\_\_\_ Ft. from E. Line

660

\_\_\_\_\_ Ft. from W. Line

Elev. 1099

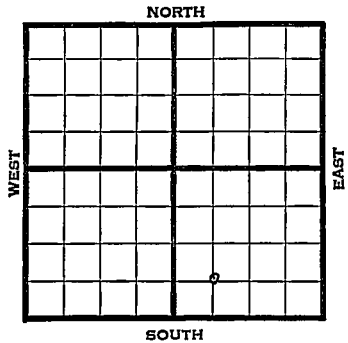

1941	REPORT
8/6	10" - 40'
	Drlg. 750'
8/15	8" @ .881'
	Bart. 1430-37 T.D.
	good show free oil
	6" @ 1437 WOC
8/21	Miss. 1478' T.D. 1503'
	P.B. to 1461'
	Shot 60 qts. 1437-59'
	Pipe collapsed.
8/28	Shut down.
9/3	Miss. 1478'
	6" - 1437'
	T.D. 1503'
	Pipe collapsed.
	<b>ABANDONED</b>

**KANSAS**

 Map No.        Sec. 33 Twp. 9 R. 20E
Well No. 2 BartlettLongwell etal CompanyFIRST REPORT Contractor

## SECTION PLAT

C SW SE  
 \_\_\_\_\_ Ft. from N. Line

660 Ft. from S. Line

\_\_\_\_\_ Ft. from E. Line

660 Ft. from W. Line

		o	

## MISCELLANEOUS

Location \_\_\_\_\_

Rig up \_\_\_\_\_

Drilling and Remarks:

10" - 40

Drlg. 750

## RECORD

Cased \_\_\_\_\_ in., \_\_\_\_\_ ft.

Sand \_\_\_\_\_

Gas \_\_\_\_\_

Oil \_\_\_\_\_

Total Depth \_\_\_\_\_

## PRODUCTION

1st 24 hrs. Nat. \_\_\_\_\_

1st 24 hrs. after shot \_\_\_\_\_

Gas \_\_\_\_\_ Cu. Ft.

Dry Hole \_\_\_\_\_

Abandoned \_\_\_\_\_

Date

AUG 6 1941 19

S. J. LEWIS Scout

Map No. \_\_\_\_\_ Sec. 33 Twp. 9 R. 20E

Well No. 2 Bartlett

Longwell etal Company

**ABANDONED** Contractor

SECTION PLAT

		o	

C SW SE  
\_\_\_\_\_ Ft. from N. Line

660 Ft. from S. Line

\_\_\_\_\_ Ft. from E. Line

660 Ft. from W. Line

MISCELLANEOUS

Location \_\_\_\_\_

Rig up \_\_\_\_\_

Drilling and Remarks:

*Miss 1478.  
6" @ 1437  
Pipe Dr. Happed*

RECORD

Cased \_\_\_\_\_ in., \_\_\_\_\_ ft.

Sand \_\_\_\_\_

Gas \_\_\_\_\_

Oil \_\_\_\_\_

Total Depth 1503

PRODUCTION

1st 24 hrs. Nat. \_\_\_\_\_

1st 24 hrs. after shot \_\_\_\_\_

Gas \_\_\_\_\_ Cu. Ft.

Dry Hole \_\_\_\_\_

Abandoned \_\_\_\_\_

Date

SEP 3 1941

19

S. J. LEWIS

Scout