


Section 33 Township 9 Range 20E

Well No. #1 A.L. Bartlett

Company Chas. Miller

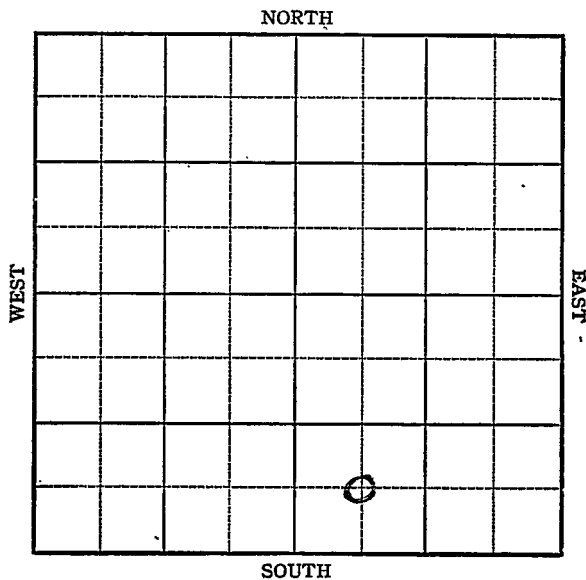

KANSAS

Jefferson

Sec. 33 Twp. 9 R. 20E

Well No. #1 A.L. Bartlett Farm

Chas. Miller Company


McLouth

 Ft. from N. Line

660 Ft. from S. Line

 Ft. from E. Line

660 Ft. from W. Line

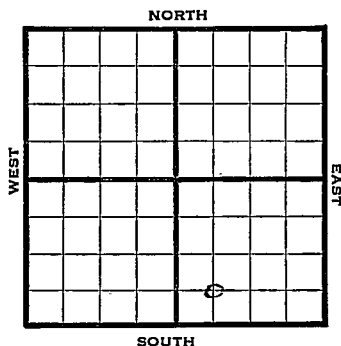

1944

REPORT

4/19 Location (tp' west dry hole)

4/26 "

5/3 "

q 5/10 10" @ 42' Drlg. 700'

5/17 T.D. 800 Shut down for 8^m

5/24 " " " " " "

5/31 " " " " "

6/7 " " " " "

6/14 Miss. 1470

6" @ 1475

TD 1658'

ABANDONED

Pool Name McLouthMap No. KANSAS Sec. 33 Twp. 9 R. 20EWell No. 1 A. L. BartlettChas. Miller CompanyFIRST REPORT Contractor

C SW SE

SECTION PLAT

/			
		o	

 Ft. from N. Line660 Ft. from S. Line Ft. from E. Line660 Ft. from W. LineJefferson CountyLocation XRig up

Drilling and Remarks:

50' west dry
hole

RECORD

Cased in., ft.Sand Gas Oil Total Depth

PRODUCTION

1st 24 hrs. Nat. 1st 24 hrs. after shot Gas Cu. Ft.Dry Hole Abandoned

Date

APR 1 9 1944 19 S. J. LEWIS Scout

KANSAS

28 200 BKS. 1 44 PETROL

Pool Name McLouth

Map No. AM Sec. 33 Twp. 9 R. 20E

Well No. 1 A. L. Bartlett

Chas. Miller Company

ABANDONED Contractor

C SW SE

SECTION PLAT

 Ft. from N. Line

660 Ft. from S. Line

 Ft. from E. Line

660 Ft. from W. Line

Jefferson County

Location

Rig up

Drilling and Remarks:

Miss 1470
6" @ 1475

RECORD

Cased in. ft.

Sand

Gas

Oil

Total Depth 1658

PRODUCTION

1st 24 hrs. Nat.

1st 24 hrs. after shot

Gas Cu. Ft.

Dry Hole

Abandoned

Date

JUN 14 1944 19

S. J. LEWIS Scout