

Jefferson

FORM 51 5M 4-41 PETROL


Section 33 Township 9 Range 20-E

Well No. #1 Kuetson

Company McLaughlin et al

Miscellaneous

NORTH

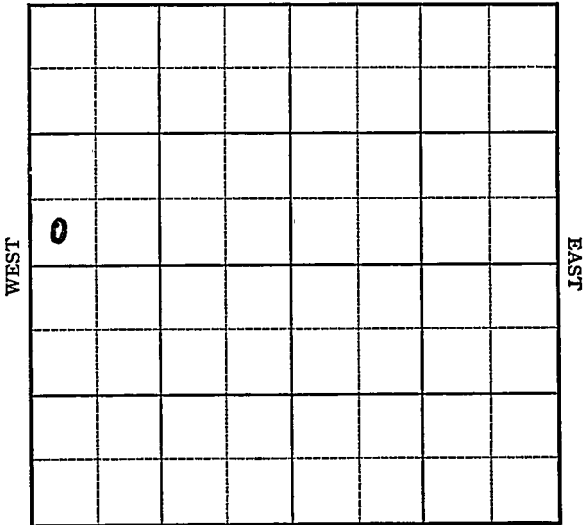

SOUTH

Map No. MM Sec. 33 Twp. 9 R. 20E

Well No. 1 Kuetson

McLaughlin etal. Company

COMPLETED Contractor

SW NW

_____ Ft. from N. Line

330 Ft. from S. Line

_____ Ft. from E. Line

330 Ft. from W. Line

SECTION PLAT

o			

MISCELLANEOUS

Location _____

Rig up _____

Drilling and Remarks:

Bar 81399

6 "C1395

6 M Bar

RECORD

Cased _____ in., _____ ft.

Sand _____

Gas _____

Oil _____

Total Depth 1426

PRODUCTION

1st 24 hrs. Nat. _____

1st 24 hrs. after shot _____

Gas _____ Cu. Ft.

Dry Hole _____

Abandoned _____

Date

NOV 5 1941 19

S. J. LEWIS Scout