

KANSAS


FORM 51 5M 10-41 PETROL

Jefferson

Section 33 Township 9 Range 20-E

Well No. #2 Knutson

Company McLaughlin et al.

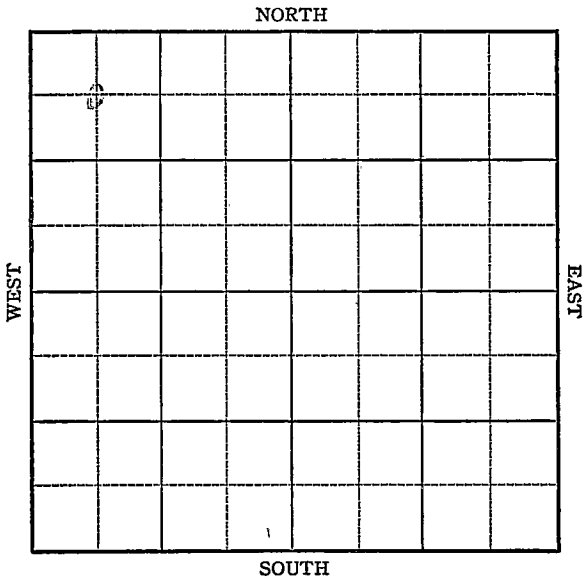

KANSASMap No. MM Sec. 33 Twp. 9 R. 20EWell No. 2 KnutsonMcLaughlin et al. CompanyFIRST REPORT Contractor

C NW NW

660 Ft. from N. Line Ft. from S. Line Ft. from E. Line660 Ft. from W. Line**SECTION PLAT**

6			

MISCELLANEOUSLocation Rig up

Drilling and Remarks:

Machine **RECORD**Cased in., ft.Sand Gas Oil Total Depth **PRODUCTION**1st 24 hrs. Nat. 1st 24 hrs. after shot Gas Cu. Ft.Dry Hole Abandoned

Date

NOV 12 1941 19 S. J. LEWIS Scout

Jefferson

KANSAS

Map No. MM Sec. 33 Twp. 9 R. 20EWell No. 2 KnutsonMcLaughlin et al. CompanyCOMPLETED Contractor

C NW NW

660 Ft. from N. Line Ft. from S. Line Ft. from E. Line660 Ft. from W. Line

SECTION PLAT

o			

MISCELLANEOUS

Location Rig up

Drilling and Remarks:

Jan 6/18986" C 189811,450,000 cu ft
gas

RECORD

Cased in., ft.Sand Gas Oil Total Depth 1408

PRODUCTION

1st 24 hrs. Nat. 1st 24 hrs. after shot Gas Cu. Ft.Dry Hole Abandoned

Date

DEC 17 1941 19S. J. LEWIS Scout