

KANSAS


Jefferson

FORM 51 5M 4-41 PETROL

Section 33 Township 9 Range 20E

Well No. 1-Lang

Company Sherrod et al

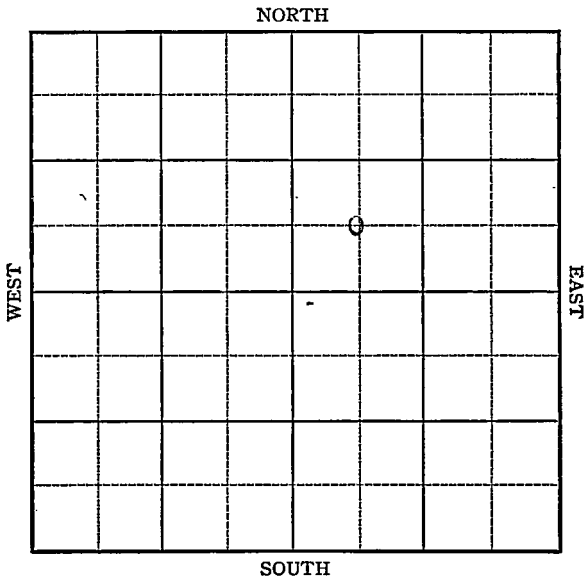

Sec. 33 Twp. 9 R. 20-E

Well No. #1 Lang Farm

Sherrod et al Company


(Misc.)

_____ Ft. from N. Line

660 Ft. from S. Line

_____ Ft. from E. Line

660 Ft. from W. Line

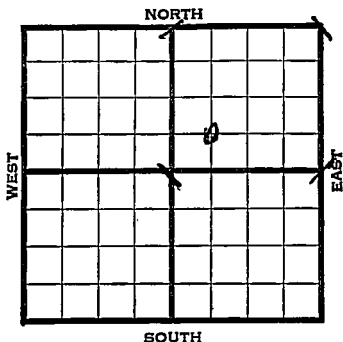

1941	REPORT
9/3	10" - 22'
	Drlg. 75'
9/11	Drlg. 700'
9/18	8" - 770' Drlg. 910'
9/25	Drlg. 1391'
10/2	SD 1391'
10/8	Bart. 1391'
	6" - 1391'
	Miss. 1426'
	T.D. 1427'
	2,020,000 cu. ft. gas.
	COMPLETED

Map No. _____ Sec. 33 Twp. 9 R. 20E

Well No. 1 Lang

Sherrod etal

Company

FIRST REPORT

Contractor

C SW NE

_____ Ft. from N. Line

660 Ft. from S. Line

_____ Ft. from E. Line

660 Ft. from W. Line

MISCELLANEOUS

SECTION PLAT

Location _____

Rig up _____

Drilling and Remarks:

10" - 22'

Drlg. 75'

RECORD

Cased _____ in., _____ ft.

Sand _____

Gas _____

Oil _____

Total Depth _____

PRODUCTION

1st 24 hrs. Nat. _____

1st 24 hrs. after shot _____

Gas _____ Cu. Ft.

Dry Hole _____

Abandoned _____

Date

SEP 3 1941 19

S. J. LEWIS

Scout

Map No. MM- Sec. 33 Twp. 9 R. 20EWell No. 1 TangSherrod etal Company~~COMPLETED~~ Contractor

C SW NE

 Ft. from N. Line660 Ft. from S. Line Ft. from E. Line660 Ft. from W. Line

MISCELLANEOUS

SECTION PLAT

Location Rig up

Drilling and Remarks:

*Bar # 1391**6" @ 1391**Miss 1426**2, 020,000 cu ft
Gas*

RECORD

Cased in., ft.Sand Gas Oil Total Depth 1427

PRODUCTION

1st 24 hrs. Nat. 1st 24 hrs. after shot Gas Cu. Ft.Dry Hole Abandoned

Date

OCT 8 1941 19S. J. LEWIS Scout