

KANSAS


Jefferson

FORM 51 5M 10-41 PETROL

Section 33 Township 9 Range 20-E

Well No. 1 Knutson

Company McLaughlin et al

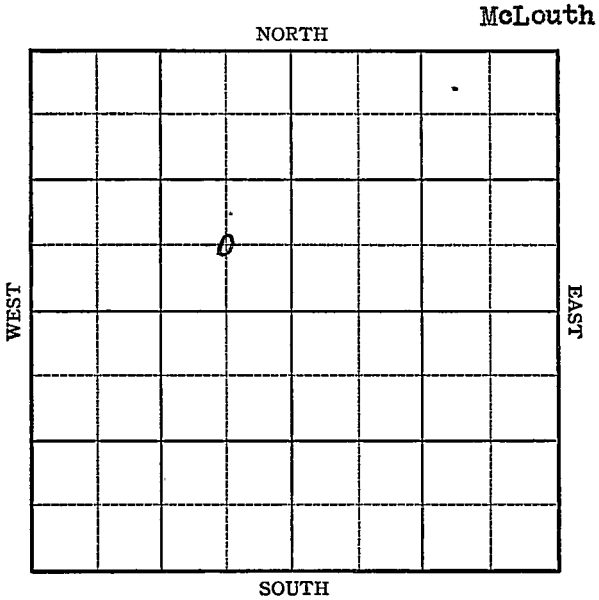

Sec. 33 Twp. 9 R. 20-E

Well No. #1 Knutson Farm

McLaughlin et al. Company

(McLouth)


_____ Ft. from N. Line

660 Ft. from S. Line

660 Ft. from E. Line

_____ Ft. from W. Line

Elev 1099

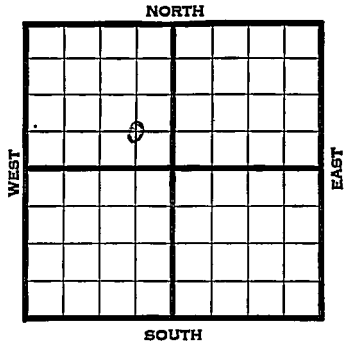

| 1941 | REPORT |
|-------|----------------------|
| 12/17 | S.D. 825 |
| 12/24 | Urlg. 1450' |
| 12/31 | 1503' T.D. Show gas. |
| | |
| 1942 | |
| 1/7 | Miss. 1492' |
| | 5" - 1490' |
| | T.D. 1503' |
| | 7/10 M gas. |
| | COMPLETED |
| | |
| | |
| | |
| | |
| | |
| | |
| | |
| | |
| | |
| | |

Map No. MM Sec. 33 Twp. 9 R. 20EWell No. 1 KnutsonMcLaughlin et al Company

Contractor

FIRST REPORT

C SE NW

_____ Ft. from N. Line

660 Ft. from S. Line660 Ft. from E. Line

_____ Ft. from W. Line

McLouth Pool

SECTION PLAT

| | | | |
|--|---|--|--|
| | | | |
| | o | | |
| | | | |
| | | | |

Location _____

Rig up _____

Drilling and Remarks:

S. D. 825

RECORD

Cased _____ in., _____ ft.

Sand _____

Gas _____

Oil _____

Total Depth _____

PRODUCTION

1st 24 hrs. Nat. _____

1st 24 hrs. after shot _____

Gas _____ Cu. Ft.

Dry-Hole _____

Abandoned _____

Date

DEC 17 1941

19

S. J. LEWIS

Scout

Map No. WM Sec. 33 Twp. 9 R. 20E

Well No. 1 Knutson

McLaughlin et al. Company

COMPLETED Contractor

C SE NW

SECTION PLAT

_____ Ft. from N. Line

660 Ft. from S. Line

660 Ft. from E. Line

_____ Ft. from W. Line

| | | | |
|--|---|--|--|
| | | | |
| | o | | |
| | | | |
| | | | |
| | | | |

MCLOUTH POOL

Location _____

Rig up _____

Drilling and Remarks:

Miss 1492
5" @ 1490
Tom Gal.

RECORD

Cased _____ in., _____ ft.

Sand _____

Gas _____

Oil _____

Total Depth 1503

PRODUCTION

1st 24 hrs. Nat. _____

1st 24 hrs. after shot _____

Gas _____ Cu. Ft.

Dry Hole _____

Abandoned _____

Date

JAN 7 1942 19

S. J. LEWIS Scout