

KANSAS


FORM 51 5M 10-41 PETROL

Leavenworth

Section 34 Township 9 Range 20-E

Well No. #1 Kell

Company John Bryan

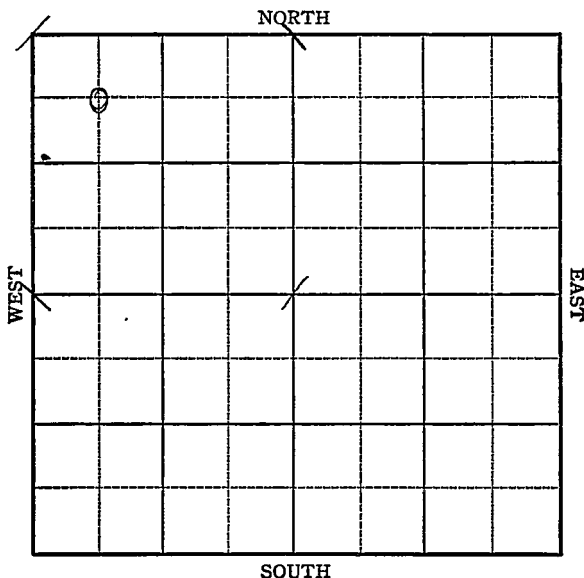

KANSAS

Leavenworth

Sec. 34 Twp. 9 R. 20-E

Well No. #1 Kell Farm


John Bryon Company

660 Ft. from N. Line

 Ft. from S. Line

 Ft. from E. Line

660 Ft. from W. Line

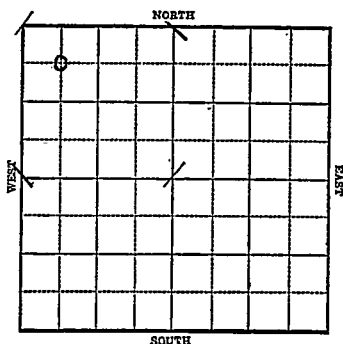

1943

R E P O R T

3/17 Location.

3/24 "

3/31 "

4/7 Drlg. 290'

4/14 Drlg. 765'

4/21 Drlg. 910'
8" @ 851'

4/28 Miss. 1437
T.D. 1441'
No shows.

ABANDONED

KANSAS Leavenworth


Map No. MM Sec. 34 Twp. 9 R. 20EWell No. 1 KellJohn Byran

Company

FIRST REPORT

Contractor

C NW NW

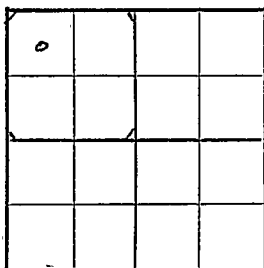660 Ft. from N. Line Ft. from S. Line Ft. from E. Line660 Ft. from W. Line**SECTION PLAT****MCLOUTH POOL**Location XXXRig up

Drilling and Remarks:

RECORDCased in., ft.Sand Gas Oil Total Depth **PRODUCTION**1st 24 hrs. Nat. 1st 24 hrs. after shot Gas Cu. Ft.Dry Hole Abandoned

Date

MAR 17 1943 19S. I. LEWIS Scout

Leavenworth

KANSAS
 Map No. WMA Sec. 34 Twp. 9 R. 20E

Well No. 1 Kell

John Byran Company

ABANDONED Contractor

C NW NW

SECTION PLAT

0			
11			

660 Ft. from N. Line Ft. from S. Line Ft. from E. Line660 Ft. from W. Line

MCLOUTH POOL

Location Rig up

Drilling and Remarks:

*Wise 1437**No logs*

RECORD

Cased in., ft.Sand Gas Oil Total Depth 1441

PRODUCTION

1st 24 hrs. Nat. 1st 24 hrs. after shot Gas Cu. Ft.Dry Hole Abandoned

Date

APR 28 1943 19 S. J. LEWIS Scout