

KANSAS

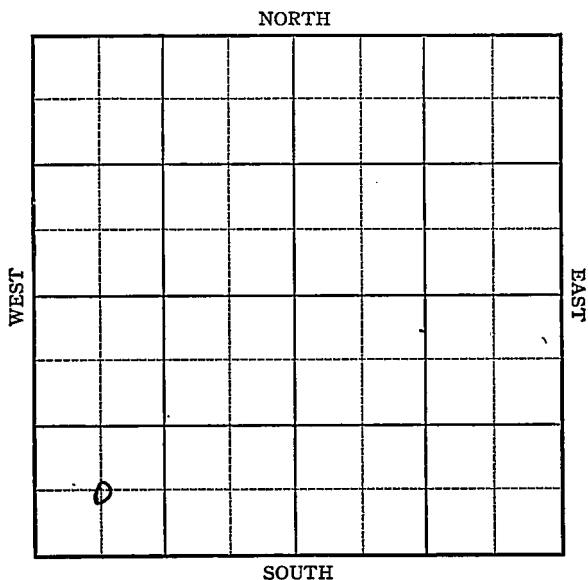
FORM 51 5M 4-41 PETROL

Leavenworth

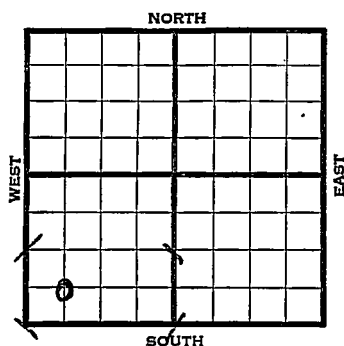
Section 34 Township 9 Range 20-E

Well No. 1 Edmons

Company A & B Pipe Line

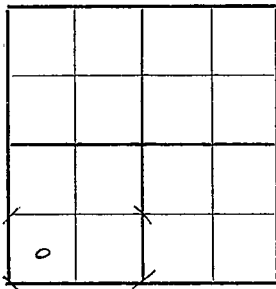


66.0 Ft. from W. Line

[illegible]

Map No. MM Sec. 34 Twp. 9 R. 20EWell No. 1 EdmonsA & B Pipe Line CompanyContractor**FIRST REPORT**

C SW SW

 Ft. from N. Line660 Ft. from S. Line Ft. from E. Line660 Ft. from W. Line**MISCELLANEOUS****SECTION PLAT**Location Rig up

Drilling and Remarks:

Machine 520**RECORD**Cased in., ft.Sand Gas Oil Total Depth **PRODUCTION**1st 24 hrs. Nat. 1st 24 hrs. after shot Gas Cu. Ft.Dry Hole Abandoned

Date

JUL 9 1941 19 S. J. LEWIS Scout

Map No. NM Sec. 34 Twp. 9 R. 20EWell No. 1 EdmonsA & B Pipeline

Company

COMPLETED

Contractor

C SW, SW Ft. from N. Line660 Ft. from S. Line Ft. from E. Line660 Ft. from W. Line

SECTION PLAT

o			

MISCELLANEOUS

Location Rig up

Drilling and Remarks:

Bar 13935" @ 1395109 to 1404-1020 " 1403-152 3/4 M Gas.963 B.T.U

RECORD

Cased in., ft.Sand Gas Oil Total Depth 1447 1/2

PRODUCTION

1st 24 hrs. Nat. 1st 24 hrs. after shot Gas Cu. Ft.Dry Hole Abandoned

Date

JUL 30 1941

19

S. J. LEWIS

Scout