

H 15 149 60043 0000


DX 78-1

KANSAS

Section 5 Township 9 Range 11E

Well No. #1 Ault

Company Morrison Drlg.

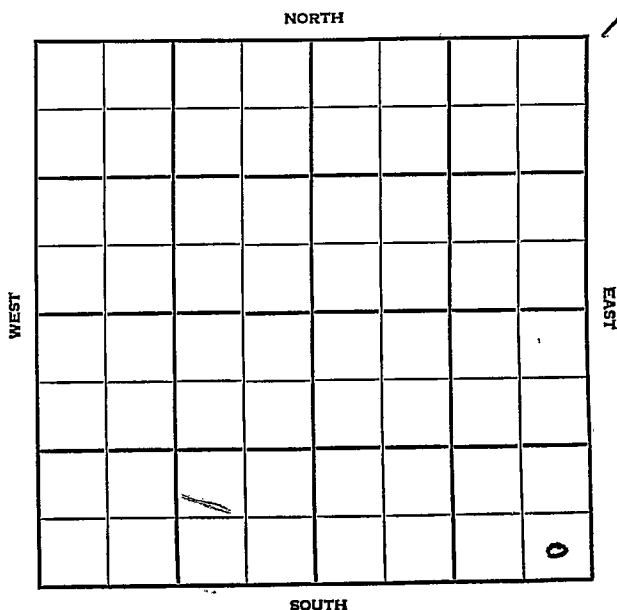


SEC.	5	TWP.	9	R.	11E
------	---	------	---	----	-----

WELL NO.	1 Ault	FARM
----------	--------	------

COMPANY	Morrison Drlg.
---------	----------------

CONTRACTOR	Co. Tools Wildcat
------------	----------------------

_____ Ft. from N. Line
330 _____ Ft. from S. Line
330 _____ Ft. from E. Line
_____ Ft. from W. Line

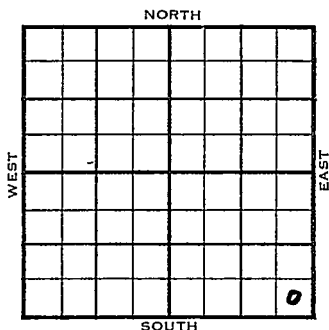

SE SE SE

1955	ELEVATION	REPORT
	1074'	

4/13

MIR

4/27

Spud 4-15-55

D &

TD 2980'

8" @ 154'

Lans. 1035' KC 1157' B KC 1364'

Cherokee 1540', Miss 1948' Kh. 2010'

Hunton 2225', Serl. Hunton 2315'

Maq. dolo. 2680', Maq. sh. 2689'

Viola 2745', Decorah 2852', Simp sh

2888' Simp sd. 2897' Weathered Arb.

2966' Weathered Gr. 2974', Gr. 2977'

TD 2980'

D & A

Lans +29

KC -83

BKC -290

Cher. -466

MISS -874

Kind -936

Hunt. -1151

Sil -1241

Maq -1606

Viola. -1671

Decorah -1778

ABANDONED

Simp sd. -1823

Arb. -1892

Gr. -1900


T.D -1900

County Pottawatomie State Kansas
 Sec. 5 (Blk. 9 (Sur. 11E Map No.

Operator Morrison D. lg.

Well No. 1 Farm Ault

Elev. 1074 Location SE SE SE

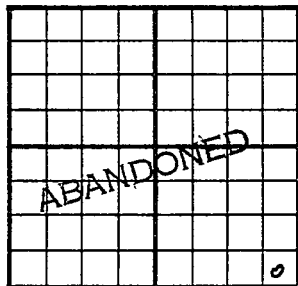

330Ft. From S Line SE

330Ft. From E Line Quarter

1st. Report

Completion APR 27 1955

Remarks Wildcat

Co. tools

Spudding Date 4-15-55

Drlg. Data D & A TD 2980

8" @ 154 Lans. 1035 KC 1157

B KC 1364 Cherokee 1540 Miss. 1948

Kh. 2010 Hunton 2225 Serl. Hunton 2315

Maq. dolo. 2680 Maq. sh. 2689

Viola 2745 Decorah 2852 Simp. sh. 2888

Simp.. sd. 2897 / Weathered Arb. 2966

Weathered Gr. 2974 Gr. 2977 TD 2980

D & A

1974
1074
-874

FABEN GILSTRAP

FABEN GILSTRAP