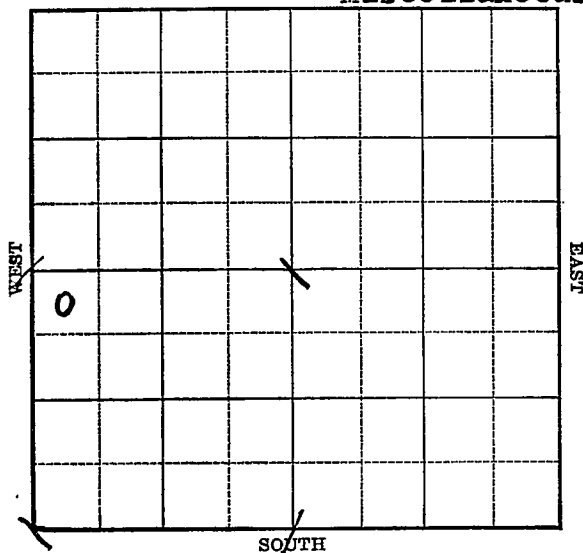


Section 8 Township 9 Range 17-EWell No. #1 BerridgeCompany Continental, Glimac & WakefieldNORTH Miscellaneous

KANSAS

Jefferson

Sec. 8 Twp. 9 R. 17-EWell No. #1 Berridge FarmContinental, Glimac & Wakefield Company

(Miscellaneous)

330


Ft. from N. Line

Ft. from S. Line

Ft. from E. Line

330

Ft. from W. Line

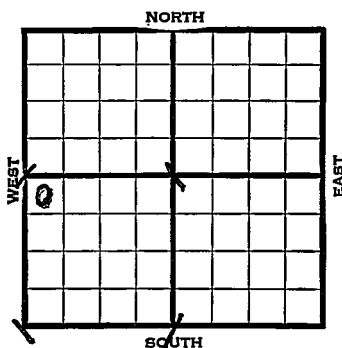

1939	El. <u>1129</u>	REPORT
7/12	Cable location	
7/20	" "	
7/26	Location.	
8/3	"	
8/10	"	$\frac{2940}{483} \div 45$
8/17	"	$\frac{2485}{2040} \div 44$
8/24	"	
8/31	Rigging up cable.	
9/7	Spud 40'	
9/14	12" - 860' Drlg. 990'	
9/21	SD 1635'	
9/28	8" - 1845' Miss. 2040'	
	Drlg. 2045'	
10/5	8" - 2039' Drlg. 2205'	
10/11	Kinderhook 2342' 6" - 2440'	
	Drlg. 2450'	
10/19	Hunton 2485' HFW 2515-20'	
	Drlg. 2685'	
	OVER	

1939

10/25

Arb. 2940' H.F.W.

T.D. 2981'

ABANDONED

Jefferson KANSAS

Map No. NM Sec. 8 Twp. 9 R. 17EWell No. 1 BerridgeContinental, Glimac & Wakefield
Company

Contractor

ABANDONED


SECTION PLAT

NW SW

330 Ft. from N. Line

_____ Ft. from S. Line

_____ Ft. from E. Line

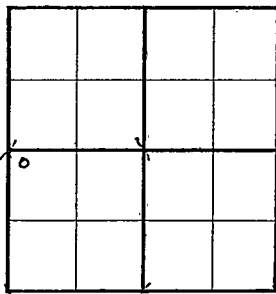330 Ft. from W. Line

MISCELLANEOUS

Location _____

Rig up _____

Drilling and Remarks:

Cu 2940HFW.

RECORD

Cased _____ in., _____ ft.

Sand _____

Gas _____

Oil _____

Total Depth 2987

PRODUCTION

1st 24 hrs. Nat. _____

1st 24 hrs. after shot _____

Gas _____ Cu. Ft.

Dry Hole _____

Abandoned _____

Date

OCT 27 1939 19S. I. LEWIS Scout

Misc. Small Maps

Cards

Tracing

France Map

Scarborough Map

Moody Map

Geological Dept.

Moody Flat Book

Map No. VM Sec. 8 Twp. 9 R. 17EWell No. 1 BerridgeContinental, Glimac & Wakefield Company

Contractor


FIRST REPORT

NW SW

330 Ft. from N. Line

_____ Ft. from S. Line

_____ Ft. from E. Line

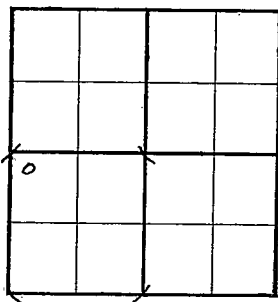330 Ft. from W. Line**SECTION PLAT****MISCELLANEOUS**Location X**RECORD**

Cased _____ in., _____ ft.

Sand _____

Gas _____

Oil _____

Total Depth _____

PRODUCTION

1st 24 hrs. Nat. _____

1st 24 hrs. after shot _____

Gas _____ Cu. Ft.

Dry Hole _____

Abandoned _____

Rig up _____
Drilling and Remarks:
Cable

Date

JUL 12 1939

19

C. J. LEWIS

Scout

Misc. Small Maps	X
Cards	<i>Paul</i>
Tracing	
France Map	✓
Scarborough Map	X
Moody Map	✓
Geological Dept.	
Moody Flat Book	