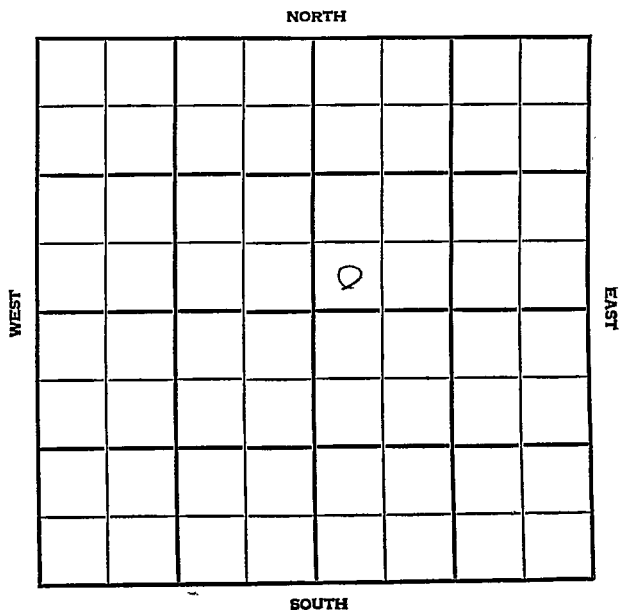


Section 1 Township 10 Range 6WWell No. #1 ShillingCompany OIL CAPITOL & FRANKFORD OIL

Lincoln

KANSAS

SEC.

1

TWP.

10

R.

6W

WELL NO.

#1 Shilling

FARM

COMPANY

Oil Capitoil & Frankford Oil

CONTRACTOR

Shields


Wildcat

____ FT. FROM N. LINE

____ FT. FROM S. LINE

____ FT. FROM E. LINE

____ FT. FROM W. LINE

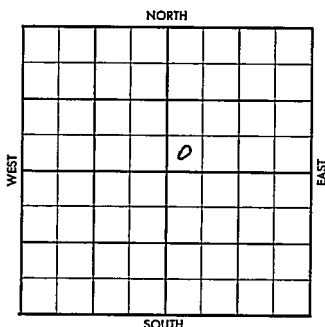SW SW NE
Arb. Test

ELEVATION

1956

1531'

REPORT

6-27

Location

8-8

Comm. 6-29-56

(1 DST in Miss.)

DST 3222-34 op 30 min. rec. 355' MSW,
BHP 1140/20". D+A

Log tops:

H. 2410'; Dg. sd. 2463'; L. 2569';

Basal 3198'; M. 3215'; Gilm. cty. 3416';

Boice sh. 3478'; Chatan sh. 3504';

Hunt Li. 3554'; Mq. sh. 3665';

Viola Lm. 3735'; Dolo 3914'; Sp. sh. 3950'

Sp. sd. 3968-93'; Arb. 4011';

TD 4053'

ABANDONED

No County Map

County Lincoln Elev. 1531
 Sec. 1 Twp. 10 Rge. SW
 Company Oil Capitol & Frankford Oil
 Farm Name Shillin No. 1

TOPS	DEPTH	LOG	DATUM	Loc. in Sec.
Anh.				SW SW NW
Tr.				Arb. test
H.		2410		
Tr.				
Dg. <u>sd</u>		2463		
BL				
L.		2569		
K.C.				Geol.
BKC.				Contr.
Ce.				
C. <u>Basal</u>		3198		Sniells
M.		3215		
M. <u>Gilmety</u>		3416		Pool
K. <u>Boise sh</u>		3428		Wildcat
M. <u>Chetan sh</u>		3504		
M. <u>Hunt</u>		3554		
* <u>Mg sh</u>		3665		
* <u>Wol</u>		3725		
S. <u>Dolo</u>		3914		
* <u>sp sh</u>		3950		
R. <u>sp sd</u>		3968-93		
PE <u>ATG</u>		4011		
G.				ABANDONED
TD	4053			

Date Comm. AUG 8 '56

Location JUL 3 '56 6-29-56

Title JUL 11 '56 ID 3470 (1 DST in Miss.) JUL 18 '56 Title JUL 25 '56 AUG 1 '56 ✓

AUG 11 '56 DST 3222-34 30" rec.

355' MSW BHP 1140/20

D&A (hand)