

KANSAS

FORM 51 IOM 12-46 PETROL

~~Wichita~~ **Rooks**

Section 1 Township 10 Range 16-W

Well No. #2 Grossbeck

Company Cities Service

NORTH

SOUTH

WEST

EAST

13

0

KANSAS

Erway Pool

Sec. 1 Twp. 10 R. 16-WWell No. 2 Grossbeck FarmCities Service Company

NW SW SW


Ft. from N. Line

990 Ft. from S. Line

Ft. from E. Line

330 Ft. from W. Line

Rooks County

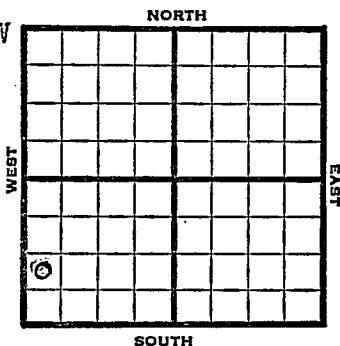

1947 1963

REPORT

2-¹²/₂ Location2/19 8" @ 240
Drlg 1890'2/26 Lans 3076
3230 In Lans
TD 3230'

ABANDONED

KANSAS

Map No. 64 Sec. 1 Twp. 10 R. 16WWell No. 2 Grossbeck

Cities Service

Company

FIRST REPORT

Contractor

NW SW SW

SECTION PLAT

o			

Ft. from N. Line

990

Ft. from S. Line

Ft. from E. Line

330

Ft. from W. Line

Rooks County

Location X

Rig up

Drilling and Remarks:

RECORD

Cased _____ in., _____ ft.

Sand _____

Gas _____

Oil _____

Total Depth _____

PRODUCTION

1st 24 hrs. Nat. _____

1st 24 hrs. after shot _____

Gas _____ Cu. Ft.

Dry Hole _____

Abandoned _____

Date

FEB 12 1947

19

S. J. LEWIS

Scout

KANSAS
Kansas

Erway Pool

Map No. 104 Sec. 1 Twp. 10 R. 16WWell No. 2 Grossbeck

Cities Service

Company

ABANDONED

Contractor

NW SW SW

E 11/1963
SECTION PLAT

0			

Ft. from N. Line

990

Ft. from S. Line

Ft. from E. Line

330

Ft. from W. Line

Rooks County

Location

Rig up

Drilling and Remarks:

*Lane 3076**3280 in Lane*

RECORD

Cased _____ in., _____ ft.

Sand _____

Gas _____

Oil _____

Total Depth 3230

PRODUCTION

1st 24 hrs. Nat. _____

1st 24 hrs. after shot _____

Gas _____ Cu. Ft.

Dry Hole _____

Abandoned _____

Date

FEB 26 1947 19

S. J. LEWIS

Scout