


Section 1 Township 10 Range 19W

Well No. #1 Mayhew

Company Aylward Drlg. et al

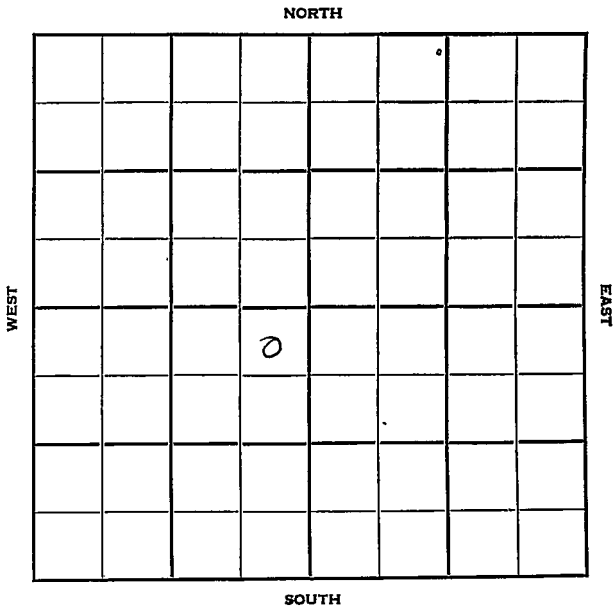

Rooks KANSAS

Sec. 1 Twp. 10 R. 19 W

Well No. # 1 Mayhew Farm

Aylward Drlg. et al Company

Aylward Contractor


330 Wildcat
Ft. from N. Line

_____ Ft. from S. Line

330 Ft. from E. Line

_____ Ft. from W. Line

NE NE SW
Stan. DHM

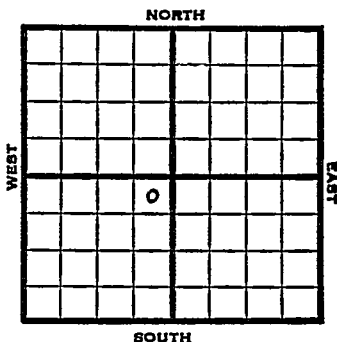


1951 Elev. 2188' REPORT

3/21 Spud 3-14-51
8" @ 186
Drlg 2815'

4/4 Spud 3-14-51
D & A TD 3746'
8" @ 186' Top. 3154', Heeb 3370'
Br Lime 3392', Lans 3412'
DST 3494-3509 open $\frac{1}{2}$ hr. Rec. 350'
water
DST 3577-89' open 20 min. Rec. 5'
mud Marmaton 3630' Cong 3719'
TD 3746' D & A

ABANDONED

County Rooks State Kansas
 Sec. 1 (Blk. 10 (Sur. 19W Map No.)
 Operator Aylward Drlg. etal.
 Well No. 1 Farm Mayhew
 Elev. 2188 Location NE NE SW

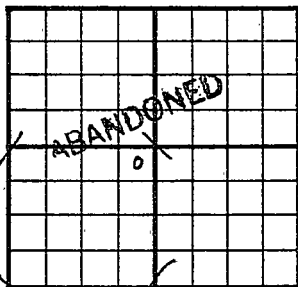

330 Ft. From N Line SW
330 Ft. From E Line Quarter
 Ist. Report
 Completion APR 4 1951
 Remarks Wildcat
Aylward - Contr.
 Spudding Date 3-14-51

Drlg. Data D & A TD 3746
8" @ 186 Top. 3154 Heeb. 3370
Br. lime 3392 Lans. 3412 DST 3494-3509
open $\frac{1}{2}$ hr. Rec. 350' water DST 3577-89
open 20 min. Rec. 5' mud Marmaton 3630
Cong. 3719 TD 3746

D & A

J. E. TYRA