

Section 1 Township 10 Range 20W

Well No. #1 Graham

Company Champlin Refg.

NORTH

|  |  |  |  |  |  |  |   |
|--|--|--|--|--|--|--|---|
|  |  |  |  |  |  |  | 6 |
|  |  |  |  |  |  |  |   |
|  |  |  |  |  |  |  |   |
1

WEST

EAST

SOUTH

Sec. 1 Twp. 10 R. 20 W ✓

Well No. # 1 Graham Farm \_\_\_\_\_

Champlin Ref. Company \_\_\_\_\_

Contractor \_\_\_\_\_


330 Ft. from N. Line

\_\_\_\_\_ Ft. from S. Line

330 Ft. from E. Line

\_\_\_\_\_ Ft. from W. Line

NORTH

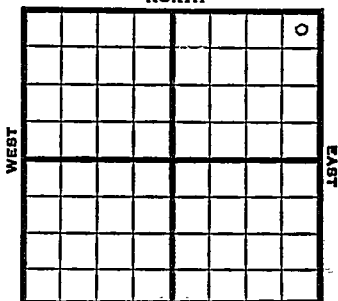

SOUTH

NE NE NE

1951

Elev. 2235' REPORT

5/9

Location

7/25

Spud 5-12-51  
 Oil well TD 3800' 8" @ 206  
 Anhy 1657' Top 3237' Heeb 3445'  
 Lans. 3479'  
 DST 3645-61 open 1 hr. rec 30' oil,  
 180' HOCM  
 Cong. 3739' Arb. 3778'  
 DST 3782-87 open 1 hr. rec 75' oil,  
 110' OCM TD 3800' 5" @ 3798'  
 CO to 3791' 12/3777-81 500 A  
 S/27 BOPH S/600 BOPD  
 Comp. 410 BOPD

**COMPLETED**


County Rooks State Kansas

Sec. 1 (Blk. Twp.) 10 (Sur. Rge.) 20W Map No.

Operator Champlin Ref.

Well No. 1 Farm Graham

Elev. \_\_\_\_\_ Location NE NE NE

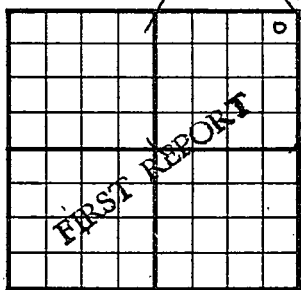

330 Ft. From N Line NE

330 Ft. From E Line Quarter

Ist. Report MAY 9 1951

Completion \_\_\_\_\_

Remarks \_\_\_\_\_

Spudding Date \_\_\_\_\_

Drlg. Data \_\_\_\_\_

**Location**


County \_\_\_\_\_ Rooks \_\_\_\_\_ State **Kansas**

Sec. **1** (Blk. Twp.) **10** (Sur. Rge.) **20W** Map No. \_\_\_\_\_

Operator **Champlin Ref.**

Well No. **1** Farm **Graham**

Elev. **2235** Location **NE NE NE**

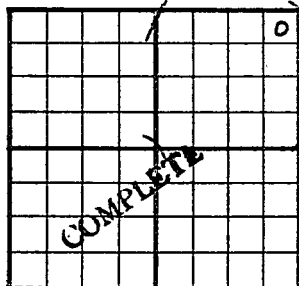

**330** Ft. From **N** Line **NE**

**330** Ft. From **E** Line **Quarter**

1st. Report \_\_\_\_\_

Completion **JUL 25 1951**

Remarks \_\_\_\_\_

Spudding Date **5-12-51**

Drlg. Data **Oil well** **TD 3800**

**8" @ 206** **Anhy 1657** **Top. 3237**

**Heeb. 3445** **Lans. 3479** **DST 3645-61**

**open 1 hr.** **Rec. 30' oil 180' hocm**

**Cong. 3739** **Arb. 3778** **DST 3782-87**

**open 1 hr.** **Rec. 75' oil 110' ocm** **TD3800**

**5" @ 3798** **CO to 3791** **12/ 3777-81**

**500 A** **S/ 27 boph** **S/ 600 bopd**

**Comp. 410 bopd**

**J. E. TYRA**