



Rooks KANSAS


SEC.	TWP.	R.
1	10	20W ✓

WELL NO. \_\_\_\_\_  
 COMPANY 1/4 Graham FARM

CONTRACTOR Champlin Refg.

Co. Tools  
Marcotte Pool

\_\_\_\_\_ Ft. from N. Line  
990 Ft. from S. Line  
 \_\_\_\_\_ Ft. from E. Line  
330 Ft. from W. Line

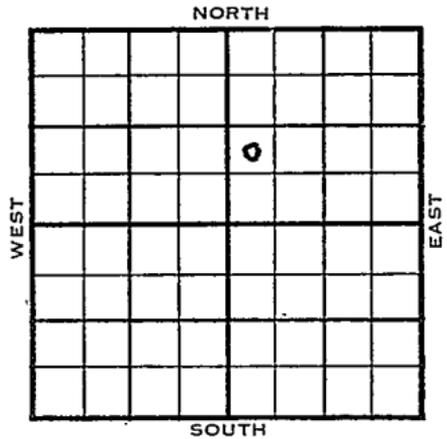

NW SW NE

	ELEVATION	REPORT
1954	2241'	

5/12 Spud 5-5-54  
 8" @ 158'  
 Anhy 1665'  
 Drlg. 2745'

5/19 Top 3239 Heeb 3447 Lans 3486  
 Cong 3743 Simp. 3778 Arb. 3795  
 RTD 3798 Schl 5" @ 3796

6/9 Spud 5-5-54 Oil well TD 3799  
 8" @ 158 Anhy 1665 Top. 3239  
 Heeb 3447 Lans 3486 Cong. 3743  
 Simp. 3778 Arb. 3795 TD 3798  
 5" @ 3796 CO to 3798 S/10 GOPH  
 8 hr. 500 M-A B/15 GOPH 8 hr.  
 DD 3799 B/15 GFPH 1% acid wtr.  
 8 hr. 1000 A S/45 1/2 BO 12 hr.  
 P/48 BO 12 hr.  
 Comp. 92 BOPD

**COMPLETED**



