


Section 1 Township 10 Range 20 W

Well No. # 6 Sutor "A"

Company Champlin Ref.

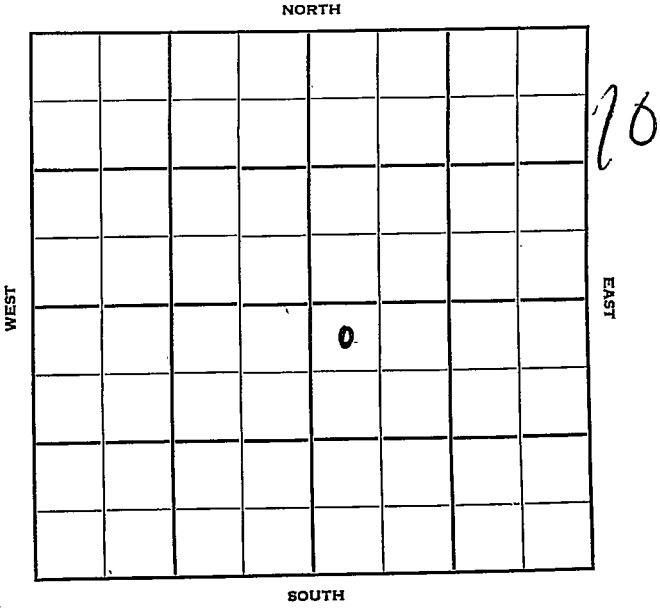

Sec. 1 Twp. 10 R. 20 W

Well No. # 6 Suter "A" Farm

Champlin Ref. Company

Champlin Contractor


330 Ft. from N. Line

..... Ft. from S. Line

..... Ft. from E. Line

330 Ft. from W. Line

NW NW SE

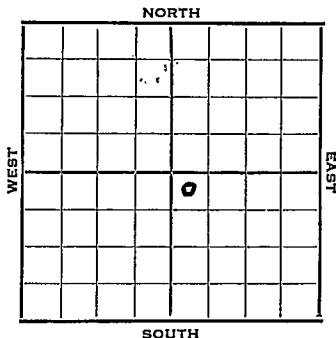

1952

Elev. 2240'

REPORT

9/4

Spud 8-27-52
8" @ 170' Anhy 1670'
Drlg. 2895'

9/10

Spud 8-27-52
D&A TD 3873
8" @ 170 Anhy 1670 Heeb. 3440
Lans. 3478
DST 3558-80 opn 1 hr. Rec. 40' ocs
1250# DST 3635-67 opn 1 hr. Rec.
155' sw 280# Cong. 3740
TD 3873 D&A

ABANDONED

County Rooks State Kansas

Sec. 1 (Blk. Twp.) 10 (Sur. Rge.) 20W Map No.

Operator Champlin Ref.

Well No. 6 Farm Sutor "A"

Elev. 2240 Location NW NW SE

| | | | | | |
|--|--|--|--|--|--|
| | | | | | |
| | | | | | |
330 Ft. From N Line SE

330 Ft. From W Line Quarter

1st. Report SEP 4 1952

Completion _____

Remarks _____

Champlin - Contr.

Spudding Date 8-27-52

Drig. Data _____

8" @ 170 Anhy 1670 drig. 2895

