

KANSAS

Section 1 Township 10 Range 20W

Well No. 1 Wilson "A"

Company Francis Oil & Gas

Berland

NORTH

0							

WEST

EAST

SOUTH

4

Sec. 1 Twp. 10 R. 20^W

Well No. #1 Wilson "A" Farm


Francis Oil & Gas Company
Berland Pool (Veeder Supply, Cont.)
NORTH

990' Ft. from N. Line

_____ Ft. from S. Line

_____ Ft. from E. Line

330' Ft. from W. Line

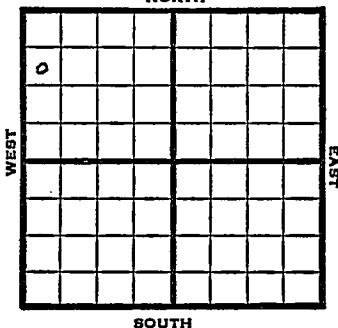

SW NW NW

1949

Elev 2250' REPORT

10/19

Surface Hole

10/26

8" @ 229'
Drlg. 3277'

11/2

TD 3855 in Cong.
Lans 3500'
BKG 3725'
Cong 3776'
Aband.
ABANDONED

Map No. _____ Sec. 1 Twp. 10 R. 20W

Well No. 1 Wilson "A"

Francis Oil & Gas Company

Veeder Supply Contractor

FIRST REPORT
SECTION PLAT

SW NW NW

990 Ft. from N. Line

_____ Ft. from S. Line

_____ Ft. from E. Line

330 Ft. from W. Line

Rooks County

RECORD

Location _____

Cased _____ in., _____ ft.

Rig up _____

Sand _____

Drilling and Remarks:

Gas _____

surface hole

Oil _____

Total Depth _____

PRODUCTION:

1st 24 hrs. Nat. _____

1st 24 hrs. after shot _____

Gas _____ Cu. Ft.

Dry Hole _____

Abandoned _____

Date

OCT 19 1949 19

S. J. LEWIS Scout

KANSAS

Map No. _____ Sec. 1 Twp. 10 R. 20WWell No. 1 Wilson "A"

Francis Oil & Gas Company

ABANDONED

Contractor

SW NW NW

E. 2250
SECTION PLAT990 Ft. from N. Line

_____ Ft. from S. Line

_____ Ft. from E. Line

330 Ft. from W. Line

Rooks County

RECORD

Location _____

Cased _____ in., _____ ft.

Rig up _____

Sand _____

Drilling and Remarks:

Gas _____

Oil _____

Total Depth 3855 in Cong

PRODUCTION

1st 24 hrs. Nat. _____

1st 24 hrs. after shot _____

Gas _____ Cu. Ft.

Dry Hole _____

Abandoned _____

Date

NOV 2 1949 19S. J. LEWIS Scout