


Section 1 Township 10 Range 20W

Well No. #6 Wilson "B"

Company Francis Oil & Gas

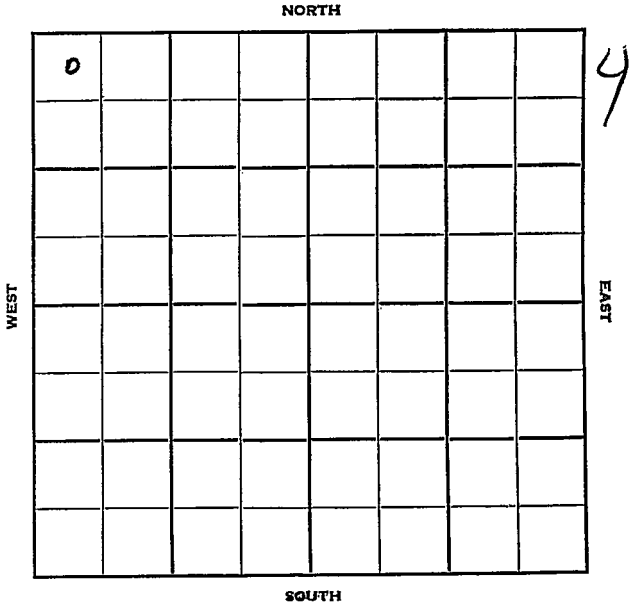

Rooks

KANSAS ✓

Sec. 1 Twp. 10 R. 20W

Well No. #6 Wilson "B" Farm

Francis Oil & Gas Company

Eagle Creek Pool Contractor


330 Ft. from N. Line

_____ Ft. from S. Line

_____ Ft. from E. Line

450 Ft. from W. Line

NW NW NW

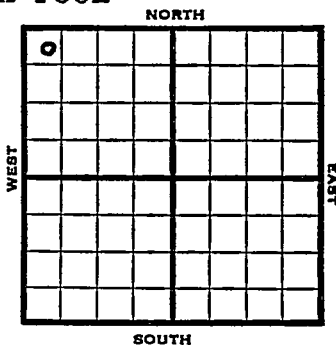

1952 **Eleg. 2251' REPORT**

11/19 Spud 11-15-52
8" @ 210
Drlg. 700'

LL/27 Anhy 1687', Heeb 3452, lans
3494
Drlg. 3506'

12/4 RTD 3786 5" @ 3779

12/11 ARB 3779 CO3786 S/42 BOPH 4 Hrs. POP

12/18 NR

12/25 NR

1953
1/7 Spud 11-15-52 Oil well TD 3786'
8" @ 210 Anhy 1687' Heeb 3452'
Lans. 3494' TD 3786' Cong. 3734'
Arb. 3779' 5" @ 3779 CO to 3786'
S/42 BOPH 4 hr. P/10 BOPH
Comp. 3000 BOPD

COMPLETED

County Rooks State Kansas

Sec. 1 (Blk. Twp.) 10 (Sur. Rge.) 20W Map No.

Operator Francis Oil & Gas

Well No. 6 Farm Wilson "B"

Elev. Location NWNW NW

8					

330 Ft. From N Line NW

450 Ft. From W Line Quarter

Ist. Report NOV 19 1952

Completion

Remarks

Spudding Date 11-15-52

Drlg. Data Eagle Creek Pool

8" 210 drlg. 700

County _____ Rooks State Kansas

Sec. 1 (Blk. 10) (Sur. 20W) (Twp.) (Rge.) Map No.

Operator Francis Oil & Gas

Well No. 6 Farm Wilson "B"

Elev. 2251 Location NW NW NW

o					

330 Ft. From N Line NW

450 Ft. From W Line Quarter

1st. Report

Completion JAN 7 1953

Remarks Eagle Creek Pool

Spudding Date 11-15-52

Drig. Data Oil well TD 3786

8" @ 210 Anhy 1687 Heeb. 3452

Lans. 3494 TD 3786 Cong. 3734

Arb. 3779 5" @ 3779 CO to 3786

S/ 42 boph 4 hr. P/ 10 boph

Comp. 3000 bopd

J. G. McGEHEE