


Section 1 Township 10 Range _____

Well No. #2 Bassett

Company D. G. Hansen

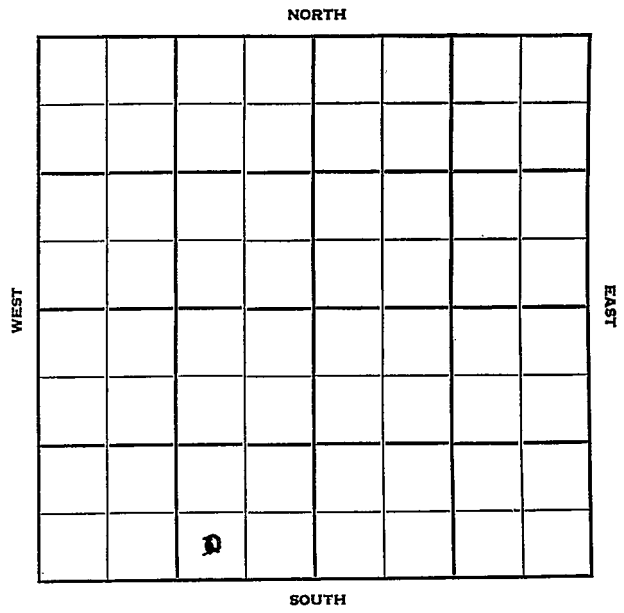

Sec. 1 Twp. 10 R. 21W

Well No. #2 Bassett Farm

D.G. Hansen Company

Cooper Contractor


 Ft. from N. Line

330' Ft. from S. Line

990' Ft. from E. Line

 Ft. from W. Line

SW SE SW

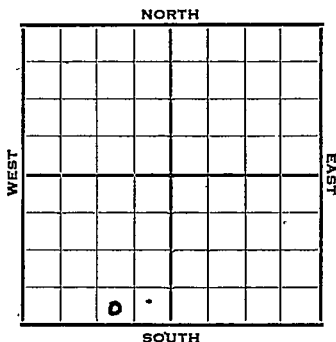

1952 Elev. 2267' REPORT

- 8/27 Location
- 9/3 8" @ 159'
Anhy 1728'
Drlg. 2760'
- 9/10 Heeb 3478' Tor 3504' Lans. 3522'
DST 3595-3615 1 hr, 93' gas & SOCM
& 90' SW ~~2110~~ 1310#
Drlg. 3710'
- 9/17 B KC 3741' Cong. 3801'
DST 3828-34, 1/2 hr, 15' OCM
DST 3828-43, 1/2 hr, 3' free oil, 12' M
440# Simp 3811' Arb. 3826'
RTD 3843' 5" @ 3843'
- 9/24 NR
- 10/1 "
- 10/8 "
- 10/15 Drlg. Deeper 3844 TD 1500A
S/53 BO 10 hrs., POP
- 10/22 NR
- 10/29 NR
- 11/5 "
- 11/12 "
- 11/20 "

OVER

1952

11/27 NR

12/4 NR

12/10 Spud 8-29-52
oil well TD 3844' 8" @ 159
Anhy 1728' Heeb 3478' Tor. 3504'
Lans. 3522'
DST 3595-3615 open 1 hr. rec 93' gas
& SOGM, 90' SW 1310#
B KC 3741' Cong. 3801'
DST 3828-34, open $\frac{1}{2}$ hr. rec 15' OCM
O#
DST 3828-43, open $\frac{1}{2}$ hr. rec 3' free
oil, 12' mud 440# Simp 3811'
Arb. 3826' TD 3844' 500 A
S/1-3/4 BOPH 1000 A S/53-1/3 BO
10 hr.
Comp. 67 BOPD

COMPLETED

County	Graham		State	Kansas	
Sec.	1	(Blk. Twp.)	10	(Sur. Rge.)	21W Map No.
Operator	D. G. Hansen				
Well No.	2	Farm	Bassett		
Elev.	2267	Location	SW SE SW		
			330 Ft. From	S Line	SW
			990 Ft. From	E Line	Quarter
			Ist. Report		
			Completion	DEC 10 1952	
			Remarks	Cooper Pool	
				C & G Drlg. - Contr.	
			Spudding Date	8-29-52	
Drlg. Data	Oil well		TD 3844		
	8" @ 159	Anhy 1728	Heeb. 3478		
	Tor. 3504	Lans. 3522	DST 3595-3615		
	open 1 hr.	Rec. 93' gas & SOCM	90' sw		
	1310#	B KC 3741	Cong. 3801		
	DST 3828-34	open $\frac{1}{2}$ hr.	Rec. 15' ocm		
	0#	DST 3828-43	open $\frac{1}{2}$ hr.	Rec. 3' free	
	oil 12' mud	440#	Simp. 3811		
	Arb. 3826	TD 3844	500 A	S/ 1 3/4 bopd	
	1000 A	S/ 53 1/3 bo	10 hr.		
	Comp. 67 bopd				

COMPLETE

J. G. McGEHEE